

SURVEY  
REMONUMENTATION

SEP 12 1995

COMMISSION

**MONTCALM COUNTY REMONUMENTATION PROGRAM**  
**LAND CORNER RECORDATION CERTIFICATE**  
Filing Requirement of Act 74, Mich. P.A. 1970

For corners in Montcalm Located In: \_\_\_\_\_ Corner Code # \_\_\_\_\_  
(County)

1. Public Land Survey Sec 9 T 11 R 6 E-4, W-1/4 Cor  
T \_\_\_\_\_ R \_\_\_\_\_  
T \_\_\_\_\_ R \_\_\_\_\_  
T \_\_\_\_\_ R \_\_\_\_\_

2. Property Controlling S \_\_\_\_\_ T \_\_\_\_\_ R \_\_\_\_\_  
in Section S \_\_\_\_\_ T \_\_\_\_\_ R \_\_\_\_\_

3. Miscellaneous S \_\_\_\_\_ T \_\_\_\_\_ R \_\_\_\_\_  
Property in Sec. S \_\_\_\_\_ T \_\_\_\_\_ R \_\_\_\_\_

4. Lot No. \_\_\_\_\_, Recorded Plat \_\_\_\_\_

5. Private Claims \_\_\_\_\_

STATE OF MICHIGAN  
MONTCALM COUNTY  
RECORDED

10 AUG 95 3:32 P.M.

VIRGINIA L. KNEPPER  
REGISTER OF DEEDS  
Register of Deeds Stamp & File Number

I, William Tingley a field survey on July 5, 1994, do hereby certify that under requirements of P.A. 74, Michigan P.A. of 1970, the corner points mentioned in lines 1 and 2 above were in conformance with regulations and rules therefore as required in the current manual of survey instructions of the United States Department of the Interior, Bureau of Land Management or by a decree of a Court of Law and/or that the corner points mentioned in lines 3, 4 and 5 above were in conformance with the rules of the Michigan Board of Land Surveyors or by a Decree of a Court of Law; established, re-established, monumented, re-monumented, recovered, found as expressed below:

NOTE: Not more than 4 corners, all in the same town and range, may be recorded on this certificate.

A. Description of original monument and accessories and/or subsequent restoration:

- 1837 John Milroy, Deputy Surveyor, GLO Notes  
Set post  
Birch 9" N70°E 21 links  
Birch 12" N3°W 17 links
- 1877, F A Palmer, County Surveyor (R D McNutts records)  
Sugar 24" N63°E 43 links  
Beech 10" N47°W 57 links
- 1884, F A Palmer, County Surveyor (R D McNutts records)  
Nearest cor of school S66°W 162 links
- 1928 R D McNutt, County Surveyor  
Stone  
Elm NE 45 feet  
Elm NE 104.3 feet
- 1937 Art Dell, County Road Department (R D McNutt, Co. Surveyor records)  
Iron rod  
Box Elder 10" NW 59.0 feet  
NE Corner Creamery, SW 96.35 feet  
Maple 12" SW 97.8 feet  
Poplar 8" NE 93.7 feet

	A	B	C	D	E	F	G	H	I	J	K	L	M
1													
2	6	5	4	3	2	1							
3													
4	7	8	9	10	11	12							
5													
6	18	17	16	15	14	13							
7													
8	19	20	21	22	23	24							
9													
10	30	29	28	27	26	25							
11													
12	31	32	33	34	35	36							
13													

ACCEPTED BY THE MONTCALM COUNTY SURVEY PEER GROUP AS THE OFFICIAL CORNER UNDER MICHIGAN PUBLIC ACT 345 OF 1990 AT A MEETING HELD 1994.08.25

*William Tingley*  
William Tingley, PS, Chairman


B. Description of corner evidence found and/or method applied in restoring or reestablishing corner:  
Found Monument Box with 2" Iron pipe, 11" long, pipe driven over a 1" solid pointed bar, which is in middle of broken clay tile.  
Dug 4 feet to sand, also found 0.5 feet North and 3.5 West found 1" x 24" pipe on Eastside of a 2.5 feet long tie rod (both 0.5 feet below pavement).

C. Description of monument for corner and accessories established to perpetuate locating the position of the corner.

- Set Remonumentation Corner and Monument Box over 1" iron in tile.
- Found Nail Westside of Power Pole S40°W 50.75 feet
- Found Nail Westside of Power Pole N45°E 46.95 feet
- Found Nail Westside of Power Pole N45°W 42.00 feet
- Top Center Concrete right of way marker N50°E 42.00 feet

This corner is accepted as a careful and faithful perpetuation of the position of the original corner.

Signed by William G. Tingley Date April, 1994  
Surveyor's Michigan License No. 30104

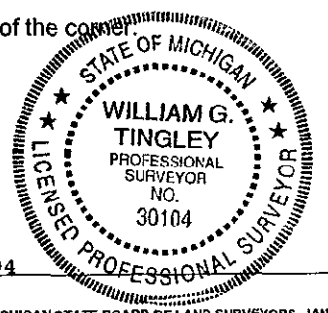

FORM APPROVED BY MICHIGAN STATE BOARD OF LAND SURVEYORS, JAN. 28, 1971  
REVISED MAY 14, 1975  
REVISED JAN., 1983  
ADAPTED FOR WORD PROCESSING MARCH, 1993