

SEP 12 1995

MONTCALM COUNTY REMONUMENTATION PROGRAM

COMMISSION

LAND CORNER RECORDATION CERTIFICATE

Filing Requirement of Act 74, Mich. P.A. 1970

For corners in
Montcalm Located In: _____ Corner Code # _____
 (County)

1. Public Land Survey Sec 9 T 11 R 6 _____ G-4, E 1/4
 Corner _____
 T _____ R _____
 T _____ R _____
 T _____ R _____

2. Property Controlling S _____ T _____ R _____
 in Section S _____ T _____ R _____
 3. Miscellaneous S _____ T _____ R _____
 Property in Sec. S _____ T _____ R _____

4. Lot No. _____, Recorded Plat _____
 5. Private Claims _____

STATE OF MICHIGAN
 MONTCALM COUNTY
 RECORDED
 10 AUG 95 3:31 P.M.
 VIRGINIA L. KNEPPER
 REGISTER OF DEEDS
 Register of Deeds Stamp & File Number

I, William Tingley a field survey on August 1, 1994, do hereby certify that under requirements of P.A. 74, Michigan P.A. of 1970, the corner points mentioned in lines 1 and 2 above were in conformance with regulations and rules therefore as required in the current manual of survey instructions of the United States Department of the Interior, Bureau of Land Management or by a decree of a Court of Law and/or that the corner points mentioned in lines 3, 4 and 5 above were in conformance with the rules of the Michigan Board of Land Surveyors or by a Decree of a Court of Law; established, re-established, monumented, re-monumented, recovered, found as expressed below:


NOTE: Not more than 4 corners, all in the same town and range, may be recorded on this certificate.

A. Description of original monument and accessories and/or subsequent restoration:
 1837 John Milroy, Deputy Surveyor, GLO Notes
 Set post
 Pine 20" N79°E 15 links
 Beech 9" S64°W 13 links
 Jan. 26, 1909 J.F. Daoust, County Surveyor, Field book 11-6, page 79
 Found monument apparently correct
 Drove flat piece of steel by side of same
 Popular 4" S49°E 58 links
 Pine stump 20" S62°W 66 1/2 links

ACCEPTED BY THE MONTCALM COUNTY SURVEY PEER GROUP AS THE OFFICIAL CORNER UNDER MICHIGAN PUBLIC ACT 345 OF 1990 AT A MEETING HELD 19 APRIL 95
William Tingley
 William Tingley, PS, Chairman

	A	B	C	D	E	F	G	H	I	J	K	L	M
1													
2	6	5	4	3	2	1							
3													
4	7	8	9	10	11	12							
5													
6	18	17	16	15	14	13							
7													
8	19	20	21	22	23	24							
9													
10	30	29	28	27	26	25							
11													
12	31	32	33	34	35	36							
13													

B. Description of corner evidence found and/or method applied in restoring or reestablishing corner:
 Found 1/2 Rerod above 1" Gas Pipe 1" x 1/4" flat stock on Westside of pipe. Found Fire Clay Mon .3 feet West of Iron Pipe. All were surrounded by nest of stones.

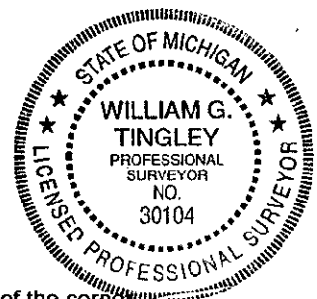

C. Description of monument for corner and accessories established to perpetuate locating the position of the corner:
 Set Remonumentation Corner over Fire Clay Monument
 Replaced 1/2" Iron Rod over Fire Clay Mon.
 Set Nail & Tag Power Pole N75°E 80.76 feet
 Set Nail & Tag Power Pole S25°E 106.83 feet
 Set Nail & tag Power Pole S65°W 113.72 feet
 Gas Pipeline Marker N50°W 50.3 feet

This corner is accepted as a careful and faithful perpetuation of the position of the original corner.

Signed by William Tingley Date April, 1994

Surveyor's Michigan License No. 30104