

SEP 1 8 1995

MONTCALM COUNTY REMONUMENTATION PROGRAM

COMMISSION

LAND CORNER RECORDATION CERTIFICATE

Filing Requirement of Act 74, Mich. P.A. 1970

For corners in
Montcalm
(County)

Located In: _____ Corner Code # _____

1. Public Land Survey Sec 9 T 11 R 6 G-5, SE Corner
 T _____ R _____
 T _____ R _____
 T _____ R _____

2. Property Controlling S _____ T _____ R _____
 in Section S _____ T _____ R _____

3. Miscellaneous S _____ T _____ R _____
 Property in Sec. S _____ T _____ R _____

4. Lot No. _____, Recorded Plat _____

5. Private Claims _____

STATE OF MICHIGAN
MONTCALM COUNTY
RECORDED

10 AUG 95 3:31 P.M.

VIRGINIA L. KNEPPER
REGISTER OF DEEDS

Register of Deeds Stamp & File Number

1	A	B	C	D	E	F	G	H	I	J	K	L	M
2		6	5	4	3	2	1						
3													
4		7	8	9	10	11	12						
5													
6		18	17	16	15	14	13						
7													
8		19	20	21	22	23	24						
9													
10		30	29	28	27	26	25						
11													
12		31	32	33	34	35	36						
13													

I, William Tingley a field surveyor on July 5, 1994, do hereby certify that under requirements of P.A. 74, Michigan P.A. of 1970, the corner points mentioned in lines 1 and 2 above were in conformance with regulations and rules therefore as required in the current manual of survey instructions of the United States Department of the Interior, Bureau of Land Management or by a decree of a Court of Law and/or that the corner points mentioned in lines 3, 4 and 5 above were in conformance with the rules of the Michigan Board of Land Surveyors or by a Decree of a Court of Law, established, re-established, monumented, re-monumented, recovered, found as expressed below:

NOTE: Not more than 4 corners, all in the same town and range, may be recorded on this certificate.


A. Description of original monument and accessories and/or subsequent restoration:
 1837, John Milroy, Deputy Surveyor, GLO Notes
 Set post
 Aspen 8" S79°W 29 links
 Elm 6" N74°E 13 links
 Jan. 26, 1909 J.F.Daoust, County Surveyor, Field book 11-6, page 78
 Relocated corner at proportionate distances, 39.68 chains from 1/4 post of 9 and 16; and 79.49 chains from SE corner, for East and West position produced line from W 1/4 post to 1/8 line, an equal distance, 19.86 chs, beyond 1/8 line. Said 1/8 line (E & W of SW 1/4) being well defined on both Sections 9 & 10. Corner thus located agrees well with immediate improvements. Drove gaspipe and set cobblestones.
 Elm 6" S18-3/4°E 166 links

ACCEPTED BY THE MONTCALM COUNTY SURVEY PEER GROUP AS THE OFFICIAL CORNER UNDER MICHIGAN PUBLIC ACT 345 OF 1990 AT A MEETING HELD 19 April 1995

William Tingley
William Tingley, PS, Chairman

B. Description of corner evidence found and/or method applied in restoring or reestablishing corner:
 Found 3/4 Iron Rod raised above 1-1/2" Gas Pipe & Nest of Stones

C. Description of monument for corner and accessories established to perpetuate locating the position of the corner:
 Set Remonumentation Corner and Monument Box over 1-1/2" gas pipe
 Nail & Tag Northside Power Pole S50°E 83.29 feet
 Top Center Riser Box S45°W 52.8 feet
 Southwest Corner Largest Riser Box N48°W 48.05 feet
 Westerly leg Stop Sign S25°E 54.17 feet
 Located Centerline "x" North-South-East-West roads

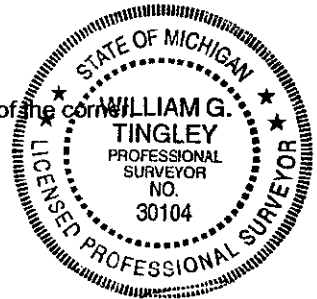

This corner is accepted as a careful and faithful perpetuation of the position of the original corner.

Signed by William Tingley Date April 19, 1994
 Surveyor's Michigan License No. 30104

A. Continued from front (M-13, 11-7)

December 12, 1963, Norman Caldwell #12018, Michigan State Highway Department, MCRC Index
Cards recorded as Southwest
31-11-6

Found 1" iron bar in monument box.

Elm 24"	N45°E	71.69 feet
Northeast corner house foundation	S21°W	74.34 feet
Maple 14"	N34°W	61.38 feet

December 20, 1984, J.S. Fokens #21567, Survey Recorded, Liber 597, Page 25

Found nail in asphalt over monument box

Nail and tag, Dead man S30°E 39.98'
Nail and tag, Maple 24" Southwest 39.8'
Nail and tag Power Pole N55°W 50.15'
Nail and tag Power Pole N55°E 76.1'

April 3, 1993, W.G. Tingley, #30104, Survey

Found Monument Box with Iron Spike

Found Nail South Side Power Pole	N45°W	49.98 feet
Found Nail West Side Power Pole	S40°E	29.65 feet
Found Nail and Tag North Side 28" Maple	S45°W	39.68 feet
Found Nail and Tag North Side Power Pole	N60°E	76.23 feet