

**SURVEY & REMONUMENTATION**

MAY 07 1997

COMMISSION

**MONTCALM COUNTY REMONUMENTATION PROGRAM  
LAND CORNER RECORDATION CERTIFICATE  
Filing Requirement of Act 74, Mich. P.A. 1970**

For corners in <u>Montcalm</u> (County)	Located In: Day Township	Corner Code #
1. Public Land Survey	Sec. 33 T <u>11N</u> R <u>6W</u> and 34	<u>G-13 South</u> <u>Boundary</u>
	T _____ R _____	_____
	T _____ R _____	_____
2. Property Controlling in Section	S _____ T _____ R _____	_____
	S _____ T _____ R _____	_____
3. Miscellaneous Property in Sec.	S _____ T _____ R _____	_____
	S _____ T _____ R _____	_____
4. Lot No. _____, Recorded Plat _____		
5. Private Claims _____		

STATE OF MICHIGAN  
MONTCALM COUNTY  
RECORDED  
  
11/14/1996 4:01:36 PM  
  
VIRGINIA L. KNEPPER  
REGISTER OF DEEDS

Register of Deeds Stamp & File Number

1	A	B	C	D	E	F	G	H	I	J	K	L	M
2	6	5	4	3	2	1							
3													
4	7	8	9	10	11	12							
5													
6	18	17	16	15	14	13							
7													
8	19	20	21	22	23	24							
9													
10	30	29	28	27	26	25							
11													
12	31	32	33	34	35	36							
13													

I, William Tingley a field surveyor on March 9, 1995, do hereby certify that under requirements of P.A. 74, Michigan P.A. of 1970, the corner points mentioned in lines 1 and 2 above were in conformance with regulations and rules therefore as required in the current manual of survey instructions of the United States Department of the Interior, Bureau of Land Management or by a decree of a Court of Law and/or that the corner points mentioned in lines 3, 4 and 5 above were in conformance with the rules of the Michigan Board of Land Surveyors or by a Decree of a Court of Law; established, re-established, monumented, re-monumented, recovered, found as expressed below:

NOTE: Not more than 4 corners, all in the same town and range, may be recorded on this certificate.

A. Description of original monument and accessories and/or subsequent restoration:  
December 7, 1836, Noah Brookfield, Deputy Surveyor, GLO Notes

- Set Post  
White Oak 20" N71°E 42 links  
Beech 10" N32°W 40 links

May 5-8, 1903, J. Claude Youdan, Deputy County Surveyor, Book 3, Page 78 Record of Surveys  
Found Tile Set by F.A. Palmer, no witnesses given (Could not find F.A. Palmer's Notes)

1903, J. Claude Youdan (Deputy County Surveyor), Book 3 Page 80 34 T11N-R6W  
Found corner established by F.A. Palmer

July 10, 1906 J.F. Daoust, County Surveyor, Book 3 Page 226  
Found monument with Stone on top

Took new Bearing Tree: Maple 7" N66-1/4°E 79 feet

R.D. McNutt files (index cards), E. Duff Youdan, County Surveyor

Found fire clay monument from notes of J.F. Daoust. Took New Bearing Tree.  
White Oak 4" S46-3/4°E 37.5 feet

Also on same card:

- MCH 1923 Ford Axle  
Maple 18" N70°E 51.6 feet  
White Oak S50°E 37.0 feet

1925, Michigan State Highway Department, STL-43, Project 5

- Found Ford Axle 1.0 feet North of Centerline  
18" Maple N70°E 51.6 feet  
10" White Oak S50°E 37.0 feet

Witnesses Found in Field Book Drawer, No Date

- Ford Axle  
18" Maple N70°E 51.6 feet  
White Oak S50°E 37.0 feet

ACCEPTED BY THE MONTCALM COUNTY SURVEY PEER GROUP AS THE OFFICIAL CORNER UNDER MICHIGAN PUBLIC ACT 345 OF 1990 AT A MEETING HELD 10/8/96

WGT  
William Tingley, PS, Chairman

Continued on back.....

B. Description of corner evidence found and/or method applied in restoring or reestablishing corner:

- Found Monument Box .5 feet below surface. Found 1/2" x 11-1/2" Steel Rod. Set over 1" x 20" Iron Pipe.  
Found Nail in 20" Walnut S06°W 31.42 feet  
Found Power Pole S50°W 75.34 feet  
Found Top Centerline of Telephone Box N50°E 55.96 feet


C. Description of monument for corner and accessories established to perpetuate locating the position of the corner:

- Set Remonumentation Corner in Monument Box in place of Pipe  
Nail in Westside 20" Walnut 31.46 feet  
6" Pine (no nail) N35°W 83.45 feet  
Top Center of Telephone Box N58°E 55.96 feet  
Nail in Westside Power Pole S56°W 75.34 feet

This corner is accepted as a careful and faithful perpetuation of the position of the original corner.

Signed by William Tingley Date 10/8/96 1996

Surveyor's Michigan License No. 30104

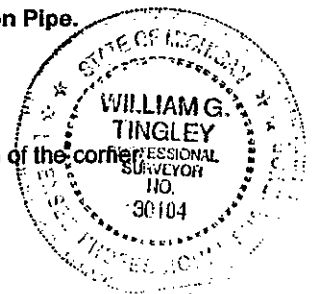

A. Continued from front (G13, 11-6)

George M. Stevenson Files (Index Cards), no date

Ford Axle

Red Oak	18"	Southeast	50.3 feet
Maple	12"	Northeast	48.7 feet
Maple	15"	Northwest	68.45 feet
Elm	12"	Northwest	47.4 feet
Maple	18"	N70°E	51.6 feet
White Oak		S50°E	37.0 feet

November 6, 1975, George M. Stevenson #13600

Found #20 Common Spike

18" Red Oak (now 28") S50°E 50.7 feet (to center) agrees closely to Youdan's Distance to H-

13

New Bearing Trees 20" Walnut	South	30.90 feet
Corner Fence Post	N50°W	55.40 feet

June 17, 1986, Thomas Mueller #25861

Found Monument Box (recorded 696-541, Liber 2, page 105)

Power Pole	Northwest	159.60 feet
Top Center Phone Box	Northeast	56.13 feet
Power Pole	Southwest	75.07 feet
Wainut 16"	South	31.16 feet

July 1, 1991, Gerald Gray, #17741, Recorded Liber 3 Page 10

Found Monument Box

Walnut 20"	S6°W	31.42 feet
Power Pole	S50°W	75.34 feet
Top Center Phone Box	N50°E	58.01 feet
"X" Top End 12" Concrete Culvert,	N64°W	59.21 feet

SURVEY &  
REMONUMENTATION

MAY 07 1997

COMMISSION