

SEP 12 1995 MONTCALM COUNTY REMONUMENTATION PROGRAM
COMMISSION LAND CORNER RECORDATION CERTIFICATE
Filing Requirement of Act 74, Mich. P.A. 1970

For corners in
Montcalm _____ Located In: _____ Corner Code # _____
(County)

1. Public Land Survey ~~Sec 36 T 11 R 6~~ M-13 SW cor
Sec 31 T 11 R 5 A-13 SW cor
T _____ R _____
T _____ R _____
T _____ R _____

2. Property Controlling _____
in Section S _____ T _____ R _____
S _____ T _____ R _____

3. Miscellaneous _____
Property in Sec. S _____ T _____ R _____

4. Lot No. _____, Recorded Plat _____

5. Private Claims _____

STATE OF MICHIGAN
MONTCALM COUNTY
RECORDED
10 AUG 95 3:35 P.M.
VIRGINIA L. KNEPPER
REGISTER OF DEEDS
Register of Deeds Stamp & File Number

	A	B	C	D	E	F	G	H	I	J	K	L	M
1													
2	6	5	4	3	2	1							
3													
4	7	8	9	10	11	12							
5													
6	18	17	16	15	14	13							
7													
8	19	20	21	22	23	24							
9													
10	30	29	28	27	26	25							
11													
12	31	32	33	34	35	36							
13													

I, William Tingley a field survey on January 12, 1994, do hereby certify that under requirements of P.A. 74, Michigan P.A. of 1970, the corner points mentioned in lines 1 and 2 above were in conformance with regulations and rules therefore as required in the current manual of survey instructions of the United States Department of the Interior, Bureau of Land Management or by a decree of a Court of Law and/or that the corner points mentioned in lines 3, 4 and 5 above were in conformance with the rules of the Michigan Board of Land Surveyors or by a Decree of a Court of Law; established, re-established, monumented, re-monumented, recovered, found as expressed below:

NOTE: Not more than 4 corners, all in the same town and range, may be recorded on this certificate.

A. Description of original monument and accessories and/or subsequent restoration:
1831 and 1837, R. Clark, Jr., Deputy Surveyor, GLO Notes
Set post
Black Ash 8" N75°E 26 links
Black Ash 12" N25°W 26 links
In old GLO notes, he states he thinks there is an error.
June 20, 1899, Lyman Foster, County Surveyor, Field Book 1, Page 72-73
Found Fire Clay mon
Took new bearing tree: Pine Stump 24" N71-1/2°W 87 links
March 31-April 12, 1913 E. Duff Youdan, County Surveyor, Recorded Book 2 Page 134, County Records
Found stake and fire clay mon as set by H.M. Caulkin many years ago (not disputed)
Took new bearing tree: Southeast bridge rail is S87° 35'W 126.1 feet
Pine Stump is N71-1/4W 56' 10", also drove knife to bean puller
1925, Michigan State Highway Department, State Trunkline 43, Project 5, Bean Puller Shoe, 4.7 feet North of Centerline at Station 297 + 41.9
July 10, 1987, B. Wickham #17639 recorded in Liber 2, Page 157
Found 3/4" iron in mon box.
Set nail & tag in Power Pole N45°W 47.85'
Set P.K. in top of Guard Post N75°W 32.22'
Set P.K. in top of Guard Post S45°W 33.75'
Street Sign Post S65°E 76.25'


ACCEPTED BY THE MONTCALM COUNTY SURVEY PEER GROUP AS THE OFFICIAL CORNER UNDER MICHIGAN PUBLIC ACT 345 OF 1990 AT A MEETING HELD 4-13-95

WGT
William Tingley, PS, Chairman

Continued on Back

B. Description of corner evidence found and/or method applied in restoring or reestablishing corner:
Found 1" o.d. iron in mon box.
Agrees with E.D. Youdan's distance to township corner, T10N-R5&6W (Youdan 2791.84 and measured 2792.65 and 1925 State Highway Department 2792.9)
Common Corner to T11N-R5 & 6W
Accepted as corner.

C. Description of monument for corner and accessories established to perpetuate locating the position of the ~~original~~ William G. Tingley
Set remonumentation corner and monument box over iron.
Nail & Tag Power Pole N79°E 96.5'
Nail & Tag 8" Ash N25°E 102.36'
Nail and Tag 10" Elm N01°W 70.50'
Nail and Tag 8" Elm S01°W 53.55'
N 1/4 Post, Section 1, T10N-R6W East 130.59 feet

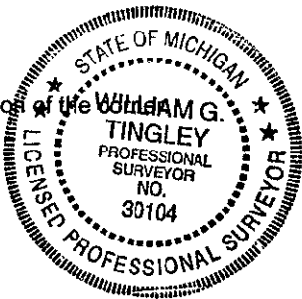

This corner is accepted as a careful and faithful perpetuation of the position of the original corner.
Signed by William Tingley Date April 13 1995
Surveyor's Michigan License No. 30104

Continued from Front (M-13, 11-6)

June 22, 1990, W.G. Tingley, #3010, Recorded Survey
Found 1" o.d. Iron in mon box.
Centerline Road North 4'
Power Pole N79°E 96.5'
8" Ash N25°E 102.36'
10" Elm N01°W 70.50'
8" Elm S01°W 53.55'
N 1/4 Post Section 1 T10N-R6W -- East 130.70'