

SURVEY & REMONUMENTATION

MONTCALM COUNTY REMONUMENTATION PROGRAM

AUG 31 1994 Corner approved by Peer Group on _____, 1994

COMMISSION

LAND CORNER RECORDATION CERTIFICATE

Filing Requirement of Act 74, Mich. P.A. 1970

STATE OF MICHIGAN
MONTCALM COUNTY
RECORDED

17 AUG 94 3:38 P.M.

VIRGINIA L. KNEPPER
REGISTER OF DEEDS

For corners in
Montcalm
(County)

Located In: _____ Corner Code # _____

1. Public Land Survey Sec 6 T 11 R 10 A-3, SW Corner
 T _____ R _____
 T _____ R _____
 T _____ R _____

2. Property Controlling S _____ T _____ R _____
 in Section S _____ T _____ R _____

3. Miscellaneous S _____ T _____ R _____
 Property in Sec. S _____ T _____ R _____

4. Lot No. _____, Recorded Plat _____

5. Private Claims _____

Register of Deeds Stamp & File Number

I, William Tingley a field survey on June 2, 1994, do hereby certify that under requirements of P.A. 74, Michigan P.A. of 1970, the corner points mentioned in lines 1 and 2 above were in conformance with regulations and rules therefore as required in the current manual of survey instructions of the United States Department of the Interior, Bureau of Land Management or by a decree of a Court of Law and/or that the corner points mentioned in lines 3, 4 and 5 above were in conformance with the rules of the Michigan Board of Land Surveyors or by a Decree of a Court of Law; established, re-established, monumented, re-monumented, recovered, found as expressed below:

NOTE: Not more than 4 corners, all in the same town and range, may be recorded on this certificate.

A. Description of original monument and accessories and/or subsequent restoration:

May 29, 1837, GLO Notes, Hodgson, Deputy Surveyor

Set Post

White Oak 9" S66°W 31 links
 White Oak 12" N62°W 47 links

September 25, 1837, GLO Notes, VanNifs, Deputy Surveyor

White Oak 12" N16°E 39 links
 White Oak 6" S28°E 20 links

May, 1907, J.F. Daoust, County Surveyor, Book 3, Page 336 and 337

Found large stone 12 x 14 x 20 with "+" on top. Stone was about 2-1/2 feet below surface.

Set gas pipe on top of stone with cobbles around same.

Poplar 7" S59°W 63 links
 Poplar 3" N42-1/2°W 79-1/2 links

October 1908, J.F. Daoust, County Surveyor, Notes Page 78, 79

Same as above.

May, 1986, Glen S. Hackbardt, #25844, Liber 601, Page 264 Montcalm County Records.

Southwest Section Corner (monument box)

Spruce 22" S45°W 64.40 feet
 Spruce 22" S75°W 180.50 feet
 Northwest Corner Steel Barn S80°E 181.30 feet

Continued on back

B. Description of corner evidence found and/or method applied in restoring or reestablishing corner:

Found 1-1/4" Gas Pipe in nest of stones below pipe, found stone with "+" 3.8 feet deep, 12.5 feet South of Mon Box.

C. Description of monument for corner and accessories established to perpetuate locating the position of the corner:

Set Remonumentation Corner above stone and gas pipe.

Found Nail 22" Spruce S45°W 58.22 feet
 Northwest Corner Steel Barn S80°E 177.0 feet
 36" Spruce (no nail) S75°W 159.45 feet
 40" White Oak (no nail) N45°E 140.50 feet

This corner is accepted as a careful and faithful perpetuation of the position or the original corner.


Signed by William Tingley Date 27 July, 1994
 Surveyor's Michigan License No. 30104

	A	B	C	D	E	F	G	H	I	J	K	L	M
1													
2	6	5	4	3	2	1							
3													
4	7	8	9	10	11	12							
5													
6	18	17	16	15	14	13							
7													
8	19	20	21	22	23	24							
9													
10	30	29	28	27	26	25							
11													
12	31	32	33	34	35	36							
13													

ACCEPTED BY THE MONTCALM COUNTY SURVEY PEER GROUP AS THE OFFICIAL CORNER UNDER MICHIGAN PUBLIC ACT 345 OF 1890 AT A MEETING HELD 27 July 94

William Tingley
 William Tingley, PS, Chairman

LIBER 3 PAGE 120

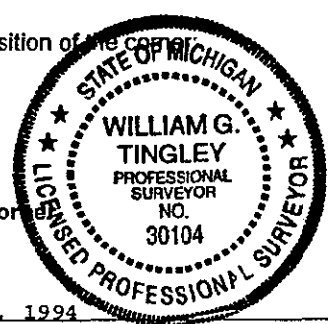

A. A-3, 6-11-10 (Continued from front)

May 1986, Glen S. Hackbardt, #25844, Liber 2, Page 129, Montcalm County Records.

LIBER 3 PAGE 121

Found Mon Box at Road Intersection.

Measured 2909.12 to B-3.

Measured 2634.86 to A-2.

Spruce 22"	S45°W	64.40 feet
Spruce 22"	S75°W	180.50 feet
Northwest Corner Steel Barn	S80°E	181.30 feet