

LAND CORNER RECORDATION CERTIFICATE
Filing Requirement of Act 74, Mich. P.A. 1970

For corners in
Montcalm County
 (County)

Located In: _____ Corner Code #/# _____


1. Public Land Survey	T	12N	R	5W	A-9
	T		R		
	T		R		
	T		R		
2. Property Controlling in Section	S	30	T	12N R 5W	B
	S	30	T	12N R 5W	16
3. Miscellaneous Property in Sec.	S		T	R	
	S		T	R	

Register of Deeds Stamp & File Number

4. Lot No. _____, Recorded Plat _____
 5. Private Claims _____

I, Gary C. Bilow, in a field survey on February, 1991, do hereby certify that under requirements of P.A. 74, Michigan P.A. of 1970, the corner points mentioned in lines 1 and 2 above were in conformance with regulations and rules therefore as required in the current manual of survey instructions of the United States Department of the Interior, Bureau of Land Management or by a decree of a Court of Law and/or that the corner points mentioned in lines 3, 4 and 5 above were in conformance with the rules of the Michigan Board of Land Surveyors or by a Decree of a Court of Law; established, re-established, monumented, re-monumented, recovered, found as expressed below:

NOTE: Not more than 4 corners, all in the same town and range, may be recorded on this certificate.

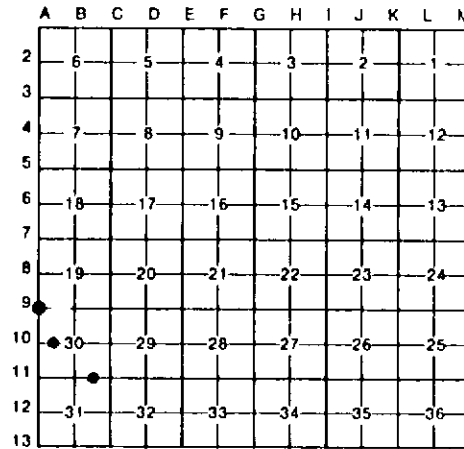

A. Description of original monument and accessories and/or subsequent restoration:

A-9: Corner established by U.S. Gov't Deputy Surveyor J. Hodgson in 1837 - accessories: Beech 10, S14W, 16 & Beech 10, N42W, 41. Corner recorded under Act 74, PA 1970 in LCRC Liber 1 Page 135 by D. Whittier (RLS10070) as "Found 3/4" pipe - accessories: S80W, Nail & Flag in NE side 22" Oak, 37.63'; S40W, N&F in E side 12" Pine, 54.14'; S20W, N&F in E side 14" Ash, 93.89' - LCRC Liber 1 Page 189 by J. Radcliff (RLS11368) as corner M-9 as "Found 3/4" pipe - accessories: 26" Oak, S80W, 37.65'; 12" Pine, S25W, 54.10'; 14" Tree, S15W, 93.88' - LCRC Liber 2 Page 271 by Tingley (RLS 30104) as "Found 1" iron pipe - accessories: Face "Deaf Child Area" Sign, N20W, 41.50'; Face Stop Sign Post, N45E, 62.00'; Top Center Riser Box, N45W, 29.95'; Set nail in E side 22" Pine, S45W, 54.25'."

B: Found no record of this corner ever being established.

16: County Surveyor J.F. Daoust records in 1905 for Section 31 "Found stake and FAP's BT agreeing - Pine stump 22, N4E, 34; Drove large pine stake."

B. Description of corner evidence found and/or method applied in restoring or reestablishing corner:

A-9: Found 2" pipe with 3/4" pipe insert approximately 18" below road surface - accessories: S80W, 28" Oak, 39.21'; S28W, Spike in 14" Pine, 54.17'; S16W, 19" Oak, 93.82'. Accepted this iron as the best evidence of the original GLO corner.

B: Established corner using single proportional measurement for 20 chains from C1/4 corner from GLO Plat values and the measured distance between corners A-10 and B-10.

16: No evidence recovered. Established corner on line and equidistant between corners B-11 and C-11.

C. Description of monument for corner and accessories established to perpetuate locating the position of the corner:

A-9: Found 2" pipe with 3/4" pipe insert and raised with 1/2" x 12" capped rebar S80W 39.21', Nail & Michigan Department of Natural Resources tag in 28" Oak S16W 93.82', N&T in 19" Oak S14E 161.58', N&T in Utility Pole S28W 54.17', spike in 14" Pine

B: Set 1/2" x 36" Rebar encased in a 4" diameter concrete cylinder and capped with a cast aluminum Michigan Department of Natural Resources Tablet in 4" x 5" Pvc pipe filled with concrete at grade S15W 51.38', N&T in triple 13" Maple N48W 35.58', N&T in 18" Maple N22W 32.05', N&T in 22" Maple S13E 19.81', N&T in 12" Maple

16: Set 1/2" x 26" Rebar encased in a 4" diameter concrete cylinder and capped with a cast aluminum Michigan Department of Natural Resources Tablet S84E 32.22', N&T in 7" Elm West 45.69', N&T in 7" Maple S57W 25.80', N&T in 11" Elm North 7.82', N&T in 4" Elm

Signed by Gary C. Bilow Date 5/22/91
 Surveyor's Michigan License No. 26453

FORM APPROVED BY MICHIGAN STATE BOARD OF LAND SURVEYORS, JAN. 24, 1971

