

LAND CORNER RECORDATION CERTIFICATE
Filing Requirement of Act 74, Mich. P.A. 1970

For corners in
Montcalm County
(County)

Located In: _____ Corner Code *##* _____

1. Public Land Survey	T	<u>12</u> N	R	<u>5</u> W	<u>D-9</u>
	T	_____	R	_____	_____
	T	_____	R	_____	_____
	T	_____	R	_____	_____
2. Property Controlling in Section	S	<u>29</u>	T	<u>12</u> N R <u>5</u> W	<u>12</u>
	S	<u>29</u>	T	<u>12</u> N R <u>5</u> W	<u>15</u>
3. Miscellaneous Property in Sec.	S	_____	T	_____ R	_____
	S	_____	T	_____ R	_____

Register of Deeds Stamp & File Number

4. Lot No. _____, Recorded Plat _____
 5. Private Claims _____

A	B	C	D	E	F	G	H	I	J	K	L	M
2	6	5	4	3	2	1						
3												
4	7	8	9	10	11	12						
5												
6	18	17	16	15	14	13						
7												
8	19	20	21	22	23	24						
9												
10	30	29	28	27	26	25						
11												
12	31	32	33	34	35	36						
13												

I, Gary C. Bilow, in a field survey on February, 1991, do hereby certify that under requirements of P.A. 74, Michigan P.A. of 1970, the corner points mentioned in lines 1 and 2 above were in conformance with regulations and rules therefore as required in the current manual of survey instructions of the United States Department of the Interior, Bureau of Land Management or by a decree of a Court of Law and/or that the corner points mentioned in lines 3, 4 and 5 above were in conformance with the rules of the Michigan Board of Land Surveyors or by a Decree of a Court of Law; established, re-established, monumented, re-monumented, recovered, found as expressed below:

NOTE: Not more than 4 corners, all in the same town and range, may be recorded on this certificate.

A. Description of original monument and accessories and/or subsequent restoration:

- D-9: J. F. Daoust records in Feb. 1906 in the County Survey Records "Found gaspipe as set by Caukin, took NBT Oak 4" N3W 39.5 links." Corner recorded under Act 74, P.A. 1970 by W. Ruddlel (RLS #14769) in Liber 2 Page 233 as "Found pipe under blacktop - accessories: N 27.9', N&C in corner fence post; SE 49.4', N&C in 8" Elm; N55W 69.4', N&C in 12" Oak."
- 12: County Surveyor F.A. Palmer in 1884 set and recorded corner in County Surveyor Records - accessory: Pine 20 N4-1/2E 71-1/2. County Surveyor J.F. Daoust in 1906 records in County Surveyor Records "Found stone and BT - Pine 20 N1-1/2W 70, agreeing. Took NBT - White Oak 6 S62-1/2W 66-1/2." Daoust in 1923 records "Found stone point up for corner agreeing with BT by Palmer and Caukin - Pine stump 20 N1-1/2W 46' and remains of BT - Oak stump 6 S62-1/2W 44'. Set crockery around stone and took NBT's - Oak 7 N62-3/4W 42.3', B. Oak 10 N4-1/4E 34.3', and E. Oak 12 S1-1/4E 29.5'."
- 15: County Surveyor J.F. Daoust in 1906 set and recorded in County Surveyor Records "Drove stake and took BT - Tamarack B S6-1/4W 32-1/2."


B. Description of corner evidence found and/or method applied in restoring or reestablishing corner:

- D-9: Found 3/4" Buggy Axle 3" under blacktop and 2 witnesses - 22" Oak, N2W, 40.15 links & nail & cap in fence post, N, 27.9'. Accepted this corner as the best evidence of the original Glo corner. Placed monument box at corner.
- 12: Found stone and crockery - no accessories recovered. Stone and crockery is 3.8' west of N-S 1/4 line and 3.0' north of E-W 1/16 line. Established corner on line and equidistant between C-11 and D-11.
- 15: No evidence recovered. Established corner on line and equidistant between C-11 and D-11.

C. Description of monument for corner and accessories established to perpetuate locating the position of the corner:

- | | | |
|--|--|--|
| D-9: Found 3/4" Buggy Axle | 12: Set 1/2" x 36" Rebar encased in 4" | 15: Set 1/2" x 36" Rebar encased in 4" |
| N2W 26.50', Nail & Michigan Department of Natural Resources tag in 22" Oak | diameter concrete cylinder and capped with a cast aluminum Michigan Department of Natural Resources Tablet | diameter concrete cylinder and capped with a cast aluminum Michigan Department of Natural Resources Tablet |
| N11E 26.91', N&T in fence post | S5W 29.18', N&T in 24" Oak | with a 4" x 5' PVC pipe placed around the monument |
| S42E 59.55', PK nail in NW face Power Pole | S34E 13.39', N&T in twin 4"/8" Oak | S50E 6.61', N&T in 5" Oak |
| N7BW 152.31', N&T in S face Power Pole | N67E 30.80', N&T in 12" Oak | S50W 9.37', N&T in 5" Oak |
| | S59W 12.09', N&T in 4" Oak | N25W 7.38', N&T in 6" Oak |
| | | N43E 4.21', N&T in 6" Oak |

Signed by Gary C. Bilow Date 5/22/91
 Surveyor's Michigan License No. 26453

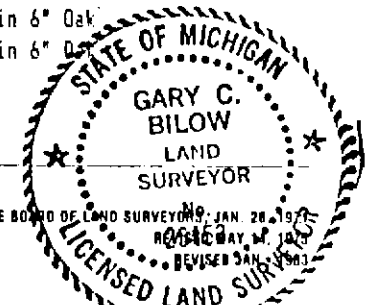

FORM APPROVED BY MICHIGAN STATE BOARD OF LAND SURVEYORS, JAN. 28, 1970