

**SURVEY &
REMONUMENTATION**

MONTCALM COUNTY REMONUMENTATION PROGRAM

AUG 31 1994 Corner approved by Peer Group on _____, 1994

COMMISSION

LAND CORNER RECORDATION CERTIFICATE
Filing Requirement of Act 74, Mich. P.A. 1970

STATE OF MICHIGAN
MONTCALM COUNTY
RECORDED

17 AUG 94 3:47 P.M.

VIRGINIA L. KNEPPER
REGISTER OF DEEDS

For corners in Montcalm Located In: _____ Corner Code # _____
(County)

1. Public Land Survey Sec 9 T 12 R 5 F-5, S 1/4
T _____ R _____
T _____ R _____
T _____ R _____

2. Property Controlling S _____ T _____ R _____
in Section S _____ T _____ R _____

3. Miscellaneous S _____ T _____ R _____
Property in Sec. S _____ T _____ R _____

4. Lot No. _____, Recorded Plat _____

5. Private Claims _____

Register of Deeds Stamp & File Number

I, William Tingley a field survey on June 21, 1994, do hereby certify that under requirements of P.A. 74, Michigan P.A. of 1970, the corner points mentioned in lines 1 and 2 above were in conformance with regulations and rules therefore as required in the current manual of survey instructions of the United States Department of the Interior, Bureau of Land Management or by a decree of a Court of Law and/or that the corner points mentioned in lines 3, 4 and 5 above were in conformance with the rules of the Michigan Board of Land Surveyors or by a Decree of a Court of Law; established, re-established, monumented, re-monumented, recovered, found as expressed below:

NOTE: Not more than 4 corners, all in the same town and range, may be recorded on this certificate.

A. Description of original monument and accessories and/or subsequent restoration:
November 1838, Enoch Hammil, Deputy Surveyor, GLO Notes

- Set Post
Beech 12" S72°E 12 links
Beech 8" S48°W 33 links
1884, F.A. Palmer, R.D. McNutt's Index Cards
New Bearing Trees
Pine Stump 30" S80°W 29 links
Pine stump 36" S60°E 39-1/2 links

April, 1890, H.M. Caulkin, County Surveyor, Book 3, page 18
Found Iron Pipe

B. Description of corner evidence found and/or method applied in restoring or reestablishing corner:
Found 1-1/2" I.D. Pipe 0.3' below surface (bent)
Found nest of stones, 1.0 feet below surface around pipe

Accepted as corner.

ACCEPTED BY THE MONTCALM COUNTY SURVEY PEER GROUP AS THE OFFICIAL CORNER UNDER MICHIGAN PUBLIC ACT 345 OF 1990 AT A MEETING HELD 29 July

LIBER 3 PAGE 116


William Tingley
William Tingley, PS, Chairman

C. Description of monument for corner and accessories established to perpetuate locating the position of the corner:

- Set Remonumentation Corner and Monument Box over 1-1/2" pipe in stones in Centerline of road and tree row to North
- | | | |
|--|-------|-------------|
| Set Nail & Tag Eastside 8" Ash | North | 37.82 feet |
| Set Nail & Tag Southside 30" White Oak | N68°W | 42.84 feet |
| Set Nail & Tag Northside power pole | S68°W | 139.55 feet |
| Northeast Corner Stone Barn Foundation | S20°W | 131.80 feet |

This corner is accepted as a careful and faithful perpetuation of the position of the original corner.

Signed by William Tingley Date 29 July 1994

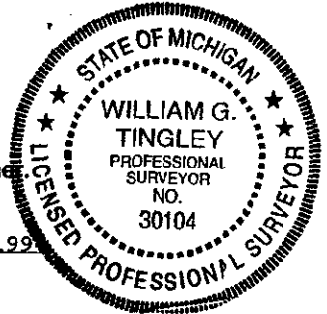

Surveyor's Michigan License No. 30104