

**SURVEY &  
REMONUMENTATION**

SEP 12 1995

**MONTCALM COUNTY REMONUMENTATION PROGRAM**

**LAND CORNER RECORDATION CERTIFICATE**

**COMMISSION**

**Filing Requirement of Act 74, Mich. P.A. 1970**

For corners in  
Montcalm Located In: \_\_\_\_\_ Corner Code # \_\_\_\_\_  
(County)

1. Public Land Survey Sec 16 T 12 R 5 G-7, SE Corner  
\_\_\_\_\_  
T \_\_\_\_\_ R \_\_\_\_\_  
T \_\_\_\_\_ R \_\_\_\_\_  
T \_\_\_\_\_ R \_\_\_\_\_

2. Property Controlling S \_\_\_\_\_ T \_\_\_\_\_ R \_\_\_\_\_  
in Section S \_\_\_\_\_ T \_\_\_\_\_ R \_\_\_\_\_  
S \_\_\_\_\_ T \_\_\_\_\_ R \_\_\_\_\_

3. Miscellaneous S \_\_\_\_\_ T \_\_\_\_\_ R \_\_\_\_\_  
Property in Sec. S \_\_\_\_\_ T \_\_\_\_\_ R \_\_\_\_\_

STATE OF MICHIGAN  
MONTCALM COUNTY  
RECORDED

10 AUG 95 3:29 P.M.

VIRGINIA L. KNEPPER  
REGISTER OF DEEDS

**Register of Deeds Stamp & File Number**

4. Lot No. \_\_\_\_\_ Recorded Plat \_\_\_\_\_  
5. Private Claims \_\_\_\_\_

I, William Tingley a field survey on November 10, 1994

do hereby certify that under requirements of P.A. 74, Michigan P.A. of 1970, the corner points mentioned in lines 1 and 2 above were in conformance with regulations and rules therefore as required in the current manual of survey instructions of the United States Department of the Interior, Bureau of Land Management or by a decree of a Court of Law and/or that the corner points mentioned in lines 3, 4 and 5 above were in conformance with the rules of the Michigan Board of Land Surveyors or by a Decree of a Court of Law; established, re-established, monumented, re-monumented, recovered, found as expressed below:

**NOTE: Not more than 4 corners, all in the same town and range, may be recorded on this certificate.**

	A	B	C	D	E	F	G	H	I	J	K	L	M
1													
2	6	5	4	3	2	1							
3													
4	7	8	9	10	11	12							
5													
6	18	17	16	15	14	13							
7													
8	19	20	21	22	23	24							
9													
10	30	29	28	27	26	25							
11													
12	31	32	33	34	35	36							
13													

A. Description of original monument and accessories and/or subsequent restoration:

1838, Enoch Hammell, Deputy Surveyor, GLO Notes  
Set Post  
Pine 36" N61°W 10 links  
Maple 12" N83°E 23 links  
April, 1990, Henry M. Caukin, County Surveyor, Page 18  
Found nest of crockery and rotted stake bottom  
Set buggy axle 32 in. long in iron pipe

B. Description of corner evidence found and/or method applied in restoring or reestablishing corner:


Found Monument Box  
Found another Mon Box 1 foot below surface  
Found buggy axle driven in 1-1/2" gas pipe set in nest of stones  
Found remains of cedar stake around pipe 4.6 feet deep  
Found nail 26" Locust N50°E 37.79 feet  
Found nail 36" Locust S38°E 56.45 feet  
Found nail power pole S35°W 95.92 feet

C. Description of monument for corner and accessories established to perpetuate locating the position of the corner:

Set Remonumentation Corner and mon box over gap pipe  
Found Nail in 26" Locust N50°E 37.79 feet  
Found Nail in 36" Locust S38°E 56.45 feet  
Found Nail in Power Pole S35°W 95.92 feet  
Set Nail & Tag in 5" Ash N75°W 84.67 feet

This corner is accepted as a careful and faithful perpetuation of the position of the original corner.

Signed by William Tingley Date 19 April, 1995  
Surveyor's Michigan License No. 30104

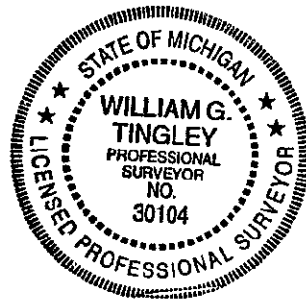

FORM APPROVED BY MICHIGAN STATE BOARD OF LAND SURVEYORS, JAN. 28, 1971  
ACCEPTED BY THE MONTCALM COUNTY SURVEY PEER GROUP AS THE OFFICIAL CORNER UNDER MICHIGAN PUBLIC ACT 345 OF 1990 AT A MEETING HELD 19 April 1995  
REVISED MAY 14, 1975  
REVISED JAN., 1983  
REVISED MARCH, 1993

William Tingley  
William Tingley, PS, Chairman