

JAN 20 2000

LAND CORNER RECORDATION CERTIFICATE


Filing Requirement of Act 74, Mich. P.A. 1970

For corners in SECTION

Montcalm (County) Located In: Corner Code #

Home Township

- 1. Public Land Survey Sec T 12 N R 06 W F-07
16, 21 T R
T R
T R
2. Property Controlling in Section S T R
S T R
3. Miscellaneous S T R
Property in Sec. S T R

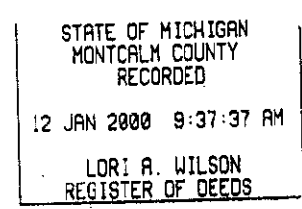

Register of Deeds Stamp & File Number

- 4. Lot No. Recorded Plat
5. Private Claims

I, William G. Tingley a field survey on June 08, 1999 do hereby certify that under requirements of P.A. 74, Michigan P.A. of 1970, the corner points mentioned in lines 1 and 2 above were in conformance with regulations and rules therefore as required in the current manual of survey instructions of the United States Department of the Interior, Bureau of Land Management or by a decree of a Court of Law and/or that the corner points mentioned in lines 3, 4 and 5 above were in conformance with the rules of the Michigan Board of Land Surveyors or by a Decree of a Court of Law; established, re-established, monumented, re-monumented, recovered, found as expressed below:

NOTE: Not more than 2 corners, all in the same town and range, may be recorded on this certificate.

- A. Description of original monument and accessories and/or subsequent restoration:
1. Nov. 2, 1837, John Milroy Deputy Survey, GLO Notes T10N - R06W East Random bet. Secs. 16&21 79.97 Intersected East Line 5 Links North of post West corrected bet. Secs. 16 & 21 0.67 Elm 8 37.51 Pine 20 39.98 1/2 Set qr. Sec post Maple 9 N6W 24 links Beech 12 S75E 24 links
2. September 19, 1881, F.A. Palmer, County Surveyor, At Mrs. Benson's SW corner Pine 30 N32°E 29 links
3. August 12th, 1912, E.O. Williams & A.A. Elliott, Chainmen Sworn, E.D.Y. Surv. qr. po. 16 & 21 - Reestablished equidistant on true line between adjacent section cors. Drove small gas pipe over Stake and then gas pipe 3" x 2' over same. Took NBT's Poplar 8 (n.m.) N57 1/2°W 67 1/2 feet Cen. of Large Stone N50 1/4°W 49 1/2 feet
4. No Date, R. D. McNutt Note Cards 1/4 Post 16-21 Maple 9" N06°W 24 links Beech 12" S75°E 24 links 1881 Pine Stp 22" S5 1/2°W 43 links
5. No Date, George Stevensons Note Cards, Gas Pipe 8" Poplar N.W. 67.5 feet Center of large stone N.W. 49.5 feet (Continued on Back. . .)

Table with 13 rows and 13 columns (A-M) containing numbers 1-36 in a grid pattern.

ACCEPTED BY THE MONTCALM COUNTY SURVEY PEER GROUP AS THE OFFICIAL CORNER UNDER MICHIGAN PUBLIC ACT 345 OF 1990 AT A MEETING HELD 11/29/99

Signature: William Tingley, PS, Chairman



B. Description of corner evidence found and/or method applied in restoring or reestablishing corner: Searched at apparent location of the corner and found 3/4" Iron Pipe in the centerline of Edgar Road, 0.85' below the surface of the road and 1.0' +/- West of Pine Stump Fence Row Occupation splitting fields to the South.

- Witnessed By: (M) measured (R) recorded
East end Top Center of 16" Concrete Culvert (M) S10°W (R) South (M) 22.30' (R) 27.25'
West end Top Center of 12" Concrete Culvert (M) N43°W (R) N45°W (M) 38.90' (R) 39.00'
Nail in South side of Power Pole (M) N74°E (R) N45°E (M) 91.55' (R) 91.50'

C. Description of monument for corner and accessories established to perpetuate localing the position of the corner: F-07: Town 12 North, Range 06 West, Home Township, Montcalm County.

- Set Standard Remonumentation Pipe over 3/4" Iron. Witnessed By: (M) measured (R) recorded
East end Top Center of 16" Concrete Culvert (M) S10°W (R) South (M) 22.30' (R) 27.25'
West end Top Center of 12" Concrete Culvert (M) N43°W (R) N45°W (M) 38.90' (R) 39.00'
Nail in South side of Power Pole (M) N74°E (R) N45°E (M) 91.55' (R) 91.50'
West end Top Center of 16" Concrete Culvert (M) S55°W (M) 35.10'

This corner is accepted as the best available evidence of the position of the original corner. Bearings given are magnetic. Standard Monumentation consists of a Berntsen stainless steel 30" x 2 3/8" pipe with a brass cap stamped "MONTCALM COUNTY REMONUMENTATION", P.S. 30104.

Signed by William G. Tingley Date 01/14/00
Surveyor's Michigan License No. 30104

LIBER 4 PAGE 204



Section A. Continued (F-7, 12-6)

- 6. June 13, 1989, William Tingley R.L.S. # 30104
Found 1/2" Iron Pipe Located center of Road

Set nail South side pp	N45°E	91.50 feet
Set nail West side wood fence post	North	20.75 feet (Notes say 29.75 feet)
Top Center 16" Concrete Culvert		
East end	South	27.25 feet
Top Center 12" Concrete Culvert		
West end	N45°W	39.00 feet

- 7. No other references found.

RECORDED

JAN 20 2000

SECTION