

**SURVEY &
REMONUMENTATION**

JAN 31 2001

LIBER 3124 PAGE 909

STATE OF MICHIGAN
COUNTY OF MUSKEGON
RECEIVED FOR RECORD

200 DEC 29 AM 11: 22

SECTION

LAND CORNER RECORDATION CERTIFICATE
Filing Requirement of Act 74, Mich. P.A. 1970

For corners in

Muskegon

(County)

Located in:

Corner Code #

- | | | |
|---------------------------------------|-------------------|-------|
| 1. Public Land Survey | T 9N R 14W | B-3 |
| | T ___ R ___ | _____ |
| | T ___ R ___ | _____ |
| | T ___ R ___ | _____ |
| 2. Property Controlling
in Section | S ___ T ___ R ___ | _____ |
| | S ___ T ___ R ___ | _____ |
| 3. Miscellaneous
Property in Sec. | S ___ T ___ R ___ | _____ |
| | S ___ T ___ R ___ | _____ |

Mark Fairchild
REGISTER OF DEEDS

Register of Deeds Stamp & File Number

4. Lot No. _____, Recorded Plat _____
5. Private Claims _____

I, Ralph W VanRiper, in a field survey on Nov. 27, 2000 do hereby state that under requirements of P.A. 74, Michigan P.A. of 1970, the corner points mentioned in lines 1 and 2 above were in conformance with regulations and rules therefore as required in the current manual of survey instructions of the United States Department of the Interior, Bureau of Land Management or by a decree of a Court of Law and/or that the corner points mentioned in lines 3, 4 and 5 above were in conformance with the rules of the Michigan Board of Land Surveyors or by a Decree of a Court of Law, established, re-established, monumented, recovered, found as expressed below:

NOTE: Not more than 2 corners, all in the same town and range, may be recorded on this certificate.

A. Description of original monument and accessories and/or subsequent restoration:

1837 GLO set Quarter Section Post between Sections 6 & 7
Hemlock 6" N55°E 5L & Birch 15" S33°E 5L

1923 Muskegon County Road Commission witnesses : N 29.30' Nail in 24" Willow : SE 43.5'
Nail in tel ple : S 27.95' Nail in fence post (Same witnesses in 1950's Muskegon
County Witness Sheets

Current Muskegon County Road Commission Witness Book = RR Spike : S 7°E 38.80' 9" Poplar
: N 34.68' Fence P. (47.25') : ESE 126.65' Tel. P.

B. Description of corner evidence found and/or method applied in restoring or reestablishing corner:

Found RR Spike over Axle Shaft in Monument Box 2' South of Centerline of Asphalt
Pavement of Height-Ravenna Road Fence Line South 4' East & Fence Line North

Historical usage, documentation and evidence of corner location reviewed and ratified
by Muskegon County Peer Group 6/6/2000


C. Description of monument for corner and accessories established to perpetuate locating the position with the passage of time

Set 2 3/4" Cast Iron "County Survey" Monument in Monument Box

- | | |
|-----------------|--|
| S 77° E 144.02' | Set Spike in N side of Twin 14" Poplar |
| N 77° E 180.05' | Set Spike in N side of 20" Poplar |
| N 28° E 53.75' | Set Spike in E Side of 12" Elm |
| North 57.58' | Set Spike in E side of 12" Maple |
| S 09° E 38.75' | Set Spike in E side of 25" Ash |
| S 69° W 104.40' | Set Spike in N side of 10" Poplar |

POSITION OF SAID
RECORDED CORNER
REVIEWED & RATIFIED
BY MUSKEGON COUNTY
PEER GROUP IN ACCORDANCE
WITH PARAGRAPHS 1 & 2
OF ACT 74, P.A. 1970

RWR
6/6/00

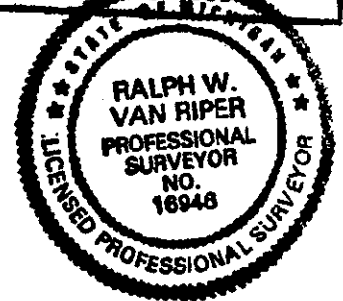

Signed by Ralph W. Van Riper
Surveyor's Michigan License No. 16948

Date 12/26/00