

FEB 09 2000

LINE 2327 PAGE 686

STATE OF MICHIGAN COUNTY OF MUSKEGON RECEIVED FOR RECORD

SECTION

LAND CORNER RECORDATION CERTIFICATE Filing Requirement of Act 74, Mich. P.A. 1970

1999 DEC 29 AM 8:36

For corners in

Muskegon

Located In:

Corner Code #

(County)

- 1. Public Land Survey T 9N R 14W C-2
- T R
- T R
- T R
- 2. Property Controlling in Section S T R
- S T R
- 3. Miscellaneous S T R
- Property in Sec. S T R

Mark Fairchild REGISTER OF DEEDS

Register of Deeds Stamp & File Number

- 4. Lot No. \_\_\_\_\_, Recorded Plat \_\_\_\_\_
- 5. Private Claims \_\_\_\_\_

I, Ralph W VanRiper, in a field survey on June 30, 1999 do hereby state that under requirements of P.A. 74, Michigan P.A. of 1970, the corner points mentioned in lines 1 and 2 above were in conformance with regulations and rules therefore as required in the current manual of survey instructions of the United States Department of the Interior, Bureau of Land Management or by a decree of a Court of Law and/or that the corner points mentioned in lines 3, 4 and 5 above were in conformance with the rules of the Michigan Board of Land Surveyors or by a Decree of a Court of Law; established, re-established, monumented, recovered, found as expressed below:

NOTE: Not more than 2 corners, all in the same town and range, may be recorded on this certificate.

1	A	B	C	D	E	F	G	H	I	J	K	L	M
2		6	●	5		4		3		2		1	
3													
4		7		8		9		10		11		12	
5													
6		18		17		16		15		14		13	
7													
8		19		20		21		22		23		24	
9													
10		30		29		28		27		26		25	
11													
12		31		32		33		34		35		36	
13													

A. Description of original monument and accessories and/or subsequent restoration:

1837 GLO set Quarter Section Post between Sections 5 & 6 Beech 12", S55°W, 23L & Sugar 8", N42°W, 11L

1980 C F Lewandoski found remains of 3/4" Iron Pipe & set 5/8" Iron Rod - LCRC, L1203, P138 S08°E, 118.92', 8" Ash; N13°W, 68.55', 4" Ash; N77°W, 36.87', 3" Ash

1993 S H Shackelford found 5/8" Iron Rod & replaced with 1/2" Steel Rod, Checked Witnesses

B. Description of corner evidence found and/or method applied in restoring or reestablishing corner:

Found 1/2 Steel Rod in Gravel of Swanson Road, verified corner location using existig Witnesses. Historical usage, documentation and evidence of corner location reviewed and ratified by Muskegon County Peer Group 5/11/99


JW 5/11/99

POSITION OF SAID RECORDED CORNER REVIEWED & RATIFIED BY MUSKEGON COUNTY PEER GROUP IN ACCORDANCE WITH P.A. 345, OF 1990

C. Description of monument for corner and accessories established to perpetuate locating the position of the

Set 2 3/4" Cast Iron "County Survey" Monument

- S 05° W 118.92' Set Nail in E side of 18" Ash
- S 14° W 111.94' Set Nail in E side of 12" dead Ash
- N 39° E 65.17' Set Nail in NW side of 6" Ash
- N 28° E 93.39' Set Nail in SW side of 6" Twin Ash
- N 11° W 68.55" Set Nail in SW side of 10" Ash
- N 74° W 36.87' Set Nail in S side of 9" Ash

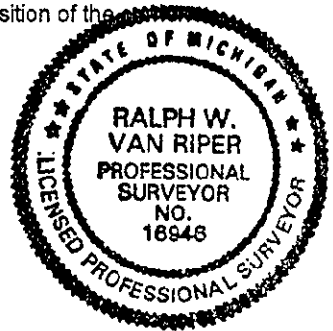

Signed by [Signature] Surveyor's Michigan License No. 16946

Date Dec. 22, 1999

A2085