

JAN 31 2001

LIBER 3124 PAGE 919

STATE OF MICHIGAN  
COUNTY OF MUSKEGON  
RECEIVED FOR RECORD

200 DEC 29 AM 11: 23

SECTION

LAND CORNER RECORDATION CERTIFICATE  
Filing Requirement of Act 74, Mich. P.A. 1970

For corners in

<u>Muskegon</u> (County)	Located in:	Corner Code #
1. Public Land Survey	T 9N R 14W	C-12
	T R	
	T R	
	T R	
2. Property Controlling in Section	S T R	
	S T R	
3. Miscellaneous Property in Sec.	S T R	
	S T R	

*Mark Fairchild*  
REGISTER OF DEEDS

Register of Deeds Stamp & File Number

4. Lot No. \_\_\_\_\_, Recorded Plat \_\_\_\_\_  
5. Private Claims \_\_\_\_\_

I, Ralph W VanRiper, in a field survey on Dec. 7, 2000 do hereby state that under requirements of P.A. 74, Michigan P.A. of 1970, the corner points mentioned in lines 1 and 2 above were in conformance with regulations and rules therefore as required in the current manual of survey instructions of the United States Department of the Interior, Bureau of Land Management or by a decree of a Court of Law and/or that the corner points mentioned in lines 3, 4 and 5 above were in conformance with the rules of the Michigan Board of Land Surveyors or by a Decree of a Court of Law; established, re-established, monumented, recovered, found as expressed below.

NOTE: Not more than 2 corners, all in the same town and range, may be recorded on this certificate.

A	B	C	D	E	F	G	H	I	J	K	L	M
1												
2	6	5	4	3	2	1						
3												
4	7	8	9	10	11	12						
5												
6	18	17	16	15	14	13						
7												
8	19	20	21	22	23	24						
9												
10	30	29	28	27	26	25						
11												
12	31	32	33	34	35	36						
13												

A. Description of original monument and accessories and/or subsequent restoration:

1837 GLO Set Quarter Section Post : Sugar 10" N16°W 17L & W Oak 24" N66°W 14L

1950's MCRC Witness Sheets shows nothing at this corner : Current MCRC Witness Book :  
1/2" Iron = W 18" Oak 52.56' : NE 45.76' T.P. : SSE 18" Oak 48.34' : S 41.90' P.P.

1972 C P Englert Recorded Surveys L988, P 146 & 148 shows 5/8" Rod & Bricks : NE 45.70' T.P. :  
WSW 52.55' 16" Oak : S 41.90' P.P. 1972 J P Clapp, Found Steel Bar : L 1002, P 708 :  
WSW 18" oak 52.56' : SE 18" Oak 48.34'

B. Description of corner evidence found and/or method applied in restoring or reestablishing corner:

Found 1/2 Rod with 3/4" Pipe 0.15' West of 1/2" Rod on Centerline of Gravel of Judson Road extended, Occupation Lines to North and West, Edge of Trees to South


Historical usage, documentation and evidence of corner location reviewed and ratified by Muskegon County Peer Group 8/1/2000

POSITION OF SAID  
RECORDED CORNER  
REVIEWED & RATIFIED  
BY MUSKEGON COUNTY  
PEER GROUP IN ACCORDANCE  
WITH P.A. 315 OF 1990

C. Description of monument for corner and accessories established to perpetuate locating the position of the corner:

Set 2 3/4" Cast Iron "County Survey" Monument

- S 05° W 41.90' Set PK Nail in W side of Power Pole
- S 85° W 52.56' Set Spike in N side of 26" Maple
- N 21° W 57.83' Set Spike in E side of Wood Fence Post
- N 02° E 87.55' Set PK Nail in W side of Power Pole
- N 49° E 43.52' Set Spike in SE Side of Twin 4" Sassafras
- S 40° E 40.58' Set Spike in SW side of 11" Oak

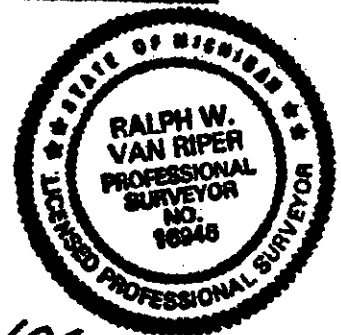

Signed by Ralph W. Van Riper  
Surveyor's Michigan License No. 16946

Date 12/26/00

A2191