

JAN 31 2001

LIBER 3124 PAGE 920

STATE OF MICHIGAN COUNTY OF MUSKEGON RECEIVED FOR RECORD

2000 DEC 29 AM 11:23

SECTION

LAND CORNER RECORDATION CERTIFICATE Filing Requirement of Act 74, Mich. P.A. 1970

For corners in

Muskegon

(County)

Located In:

Corner Code #

- 1. Public Land Survey T 9N R 14W C-13
- T R
- T R
- T R
- 2. Property Controlling in Section S T R
- S T R
- 3. Miscellaneous Property in Sec. S T R
- S T R

Mark Fairchild REGISTER OF DEEDS

Register of Deeds Stamp & File Number

- 4. Lot No. _____, Recorded Plat _____
- 5. Private Claims _____

I, Ralph W VanRiper, in a field survey on Dec. 7, 2000 do hereby state that under requirements of P.A. 74, Michigan P.A. of 1970, the corner points mentioned in lines 1 and 2 above were in conformance with regulations and rules therefore as required in the current manual of survey instructions of the United States Department of the Interior, Bureau of Land Management or by a decree of a Court of Law and /or that the corner points mentioned in lines 3, 4 and 5 above were in conformance with the rules of the Michigan Board of Land Surveyors or by a Decree of a Court of Law; established, re-established, monumented, recovered, found as expressed below:

NOTE: Not more than 2 corners, all in the same town and range, may be recorded on this certificate.

A	B	C	D	E	F	G	H	I	J	K	L	M
1												
2	6	5	4	3	2	1						
3												
4	7	8	9	10	11	12						
5												
6	18	17	16	15	14	13						
7												
8	19	20	21	22	23	24						
9												
10	30	29	28	27	26	25						
11												
12	31	32	33	34	35	36						
13												

A. Description of original monument and accessories and/or subsequent restoration:

1837 GLO Set Post Corner of Sections 31 & 32 : Sugar 10" N18°W 25L & Maple 24" N 39° E 40L 1950's & Current MCRC Witness Sheets & Book shows nothing at this corner D W Schiele on Ottawa County LCRC (L 3, P 699) for NE Corner of Section 6, T8N, R14W shows SW Corner of Section 32 as (W 26.4')

B. Description of corner evidence found and/or method applied in restoring or reestablishing corner:


Found 1/2" Rod in Rock Pile & remains of 2" Pipe in Centerline of Gravel of Wilson Road, Fence line North 2' West of Corner

Historical usage, documentation and evidence of corner location reviewed and ratified by Muskegon County Peer Group 8/1/2000

POSITION OF SAID RECORDED CORNER REVIEWED & RATIFIED BY MUSKEGON COUNTY PEER GROUP IN ACCORDANCE WITH P.A. 345 OF 1990

C. Description of monument for corner and accessories established to perpetuate locating the position of the corner:

- Set 2 3/4" Cast Iron "County Survey Monument
- S 79° W 296.23' Set PK Nail in N side of Power Pole
- N 04° W 28.12' Found Spike in E side of 6" Wood Fence Post
- S 18° W 60.85' Found Spike in NW side of Power Pole
- S 14° E 168.95' Set Spike in E side of 6" Wood Fence Post
- East 26.34' Found Broken Ottawa County Monument
- N 77° E 132.65' Set Spike in S side of 5" Wood Fence Post

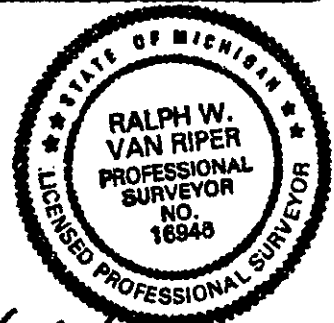

Signed by Ralph W. Van Riper Surveyor's Michigan License No. 16946

Date 12/26/00

A2192