LIBER 2327 PAGE 688

STATE OF MICHIGAN
COUNTY OF MUSKEGON
RECEIVED FOR RECORD

1999 DEC 29 AM 8: 3

REGISTER OF DEEDS

LAND CORNER RECORDATION CERTIFICATE
Filing Requirement of Act 74, Mich. P.A. 1970

For corners in

Muskegon (County) Located in: Corner Code #

1. Public Land Survey T 9N R 14W D-3
T___ R___
T___ R___
T___ R___

SURVEY & REMONUMENTATION

2. Property Controlling in Section S___ T___ R___
S___ T___ R___
3. Miscellaneous Property in Sec. S___ T___ R___
S___ T___ R___

NOV 28 2000

SECTION

Register of Deeds Stamp & File Number

4. Lot No. _____ , Recorded Plat _____
5. Private Claims _____

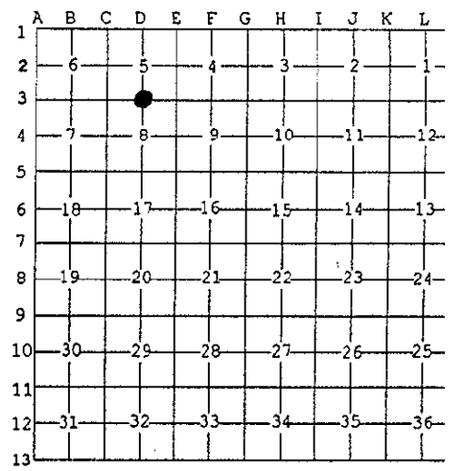

I, Ralph W VanRiper, in a field survey on June 30, 19 99 do hereby state that under requirements of P.A. 74, Michigan P.A. of 1970, the corner points mentioned in lines 1 and 2 above were in conformance with regulations and rules therefore as required in the current manual of survey instructions of the United States Department of the Interior, Bureau of Land Management or by a decree of a Court of Law and /or that the corner points mentioned in lines 3, 4 and 5 above were in conformance with the rules of the Michigan Board of Land Surveyors or by a Decree of a Court of Law; established, re-established, monumented, recovered, found as expressed below:

NOTE: Not more than 2 corners, all in the same town and range, may be recorded on this certificate.

A. Description of original monument and accessories and/or subsequent restoration:

1837 GLO set Quarter Section Post between Sec. 5 & 8; Ironwood 6" S6°E 9L & Hick. 15" N51°W 4

1971 F F Smith Found RR Spike in Mon. Box. LCRC L976, P821; Spike in a 3" Tree, S, 84.30'; End of Steel Culvert, WSW 181.10'; End of Steel Culvert, WNW 182.50'

1985 S H Shackelford Found RR Spike in Mon. Box; WNW End of CMP Culvert 182.50'; WSW End of CMP Culver 181.10'; SSE T Riser 44.00'

B. Description of corner evidence found and/or method applied in restoring or reestablishing corner:

Found RR Spike over 3/4" Iron Pipe in Mon. Box in Heights-Ravenna Road,

Historical usage, documentation and evidence of corner location reviewed and ratified by Muskegon County Peer Group 5/11/99

POSITION OF SAID RECORDED CORNER REVIEWED & RATIFIED BY MUSKEGON COUNTY PEER GROUP IN ACCORDANCE WITH P.A. 345, OF 1990 SVW 5/11/99

C. Description of monument for corner and accessories established to perpetuate locating the position of the corner:

Set 2 3/4" Cast Iron "County Survey" Monument in Mon. Box
N 82° W 240.58' Set Nail in S side of 14" Birch
N 57° W 61.15' Set Nail in NE side of 10" Willow
N 55° E 70.64' Set Nail in SE side of Triple 12" Ash
S 27° E 36.14' Set Nail in NE side of 16" Ash
S 05° E 47.55' Set Nail in E side of 11" Ash
S 01° W 77.81' Set Nail in E side of 8" Sass.

STATE OF MICHIGAN
RALPH W. VAN RIPER
PROFESSIONAL SURVEYOR
NO. 16946
LICENSED PROFESSIONAL SURVEYOR

Signed by _____ Date Dec. 22, 1999

Surveyor's Michigan License No. 16946

FORM APPROVED BY MICHIGAN STATE BOARD OF PROFESSIONAL SURVEYORS, JAN. 28, 197
REVISED MAY 14,197
REVISED JAN., 198
REVISED OCT., 199

12.27.87