

**SURVEY & REMONUMENTATION**

JAN 31 2001

LIBER 3124 PAGE 924

STATE OF MICHIGAN  
COUNTY OF MUSKEGON  
RECEIVED FOR RECORD

200 DEC 29 AM 11: 23

**SECTION**

**LAND CORNER RECORDATION CERTIFICATE**  
Filing Requirement of Act 74, Mich. P.A. 1970

*Mark Fairchild*  
REGISTER OF DEEDS

For corners in

Muskegon (County)	Located In:	Corner Code #
1. Public Land Survey	T9N R 14W	D-11
	T R	
	T R	
	T R	
2. Property Controlling in Section	S T R	
	S T R	
3. Miscellaneous Property in Sec.	S T R	
	S T R	

Register of Deeds Stamp & File Number

4. Lot No. \_\_\_\_\_, Recorded Plat \_\_\_\_\_  
5. Private Claims \_\_\_\_\_

I, Ralph W VanRiper, in a field survey on Dec. 5, 2000 do hereby state that under requirements of P.A. 74, Michigan P.A. of 1970, the corner points mentioned in lines 1 and 2 above were in conformance with regulations and rules therefore as required in the current manual of survey instructions of the United States Department of the Interior, Bureau of Land Management or by a decree of a Court of Law and/or that the corner points mentioned in lines 3, 4 and 5 above were in conformance with the rules of the Michigan Board of Land Surveyors or by a Decree of a Court of Law, established, re-established, monumented, recovered, found as expressed below:

NOTE: Not more than 2 corners, all in the same town and range, may be recorded on this certificate.

1	A	B	C	D	E	F	G	H	I	J	K	L	M
2	6		5		4		3		2		1		
3													
4	7		8		9		10		11		12		
5													
6	18		17		16		15		14		13		
7													
8	19		20		21		22		23		24		
9													
10	30		29		28		27		26		25		
11													
12	31		32		33		34		35		36		
13													

**A. Description of original monument and accessories and/or subsequent restoration:**

1837 GLO Set Quarter Section Post = Beech 10" S49°E 14L & Hemlock 8" N15°W 20L

1938 MCRC Found a Wood Stake & Replaced it with a 1 1/2" Iron Pipe 1950's MCRC Witnesses Sheets shows I. Pipe = SE 57.13' 7" M : W 21.6' 12" M Current MCRC Witness Book shows W 20.7' 26" Maple : SE 20" Maple. 57.44' : NE 29.27' 8" Locust : SE 57.13' 7" Map. : W 21.8' 12" Maple J P Clapp in 1972 Found Iron = 18" Maple SE 57.44' & 24" Maple N 20.7' F F Smith in 1976 Found 5/8" Rod = W 20.7' 26" Maple : NE 29.27' 8" Locust : SE 57.44' 20" Maple D L Herrema in 1990 and D W Schiele found 1 1/2" Iron with the same Witnesses

**B. Description of corner evidence found and/or method applied in restoring or reestablishing corner:**


Found 1/2" Rod in 1 1/2" Pipe. 1' East of Centerline of Gravel of Rollenhagen Road and Fence Lines both East and West of Corner

Historical usage, Documentation and evidence of corner location reviewed and ratified by Muskegon County Peer Group 8/1/2000

**C. Description of monument for corner and accessories established to perpetuate locating the position of the corner:**

Set 2 3/4" Cast Iron "County Survey" Monument  
 N 43° E 29.33' Found Spike in SE side of 11" Locust  
 N 80° E 18.71' Set Spike in N side of 12" Locust  
 S 24° E 57.43' Found Spike in SW side of 30" Maple  
 S 40° W 44.85' Set Spike in SW side of Wood Fence Post  
 N 89° W 45.70' Found Spike in S side of 10" Locust  
 N 41° W 49.27' Set Spike in NE side of 7" Locust

POSITION OF SAID RECORDED CORNER REVIEWED & RATIFIED BY MUSKEGON COUNTY PEER GROUP IN ACCORDANCE WITH P.A. 345, OF 1990

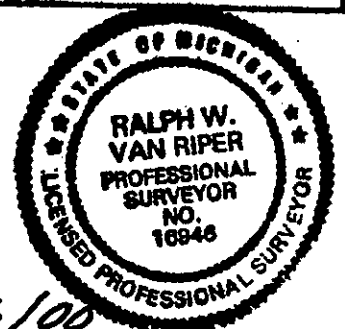

Signed by Ralph W. Van Riper  
 Surveyor's Michigan License No. 16946

Date 12/26/00

A2196