

FEB 09 2000

SECTION

LIBER 2327 PAGE 693

STATE OF MICHIGAN, COUNTY OF MUSKEGON RECEIVED FOR RECORD

1999 DEC 29 AM 8:36

LAND CORNER RECORDATION CERTIFICATE Filing Requirement of Act 74, Mich. P.A. 1970

For corners in Muskegon (County)

Located In: Corner Code #


- 1. Public Land Survey T 9N R 14W E-5
2. Property Controlling in Section S T R
3. Miscellaneous Property in Sec. S T R

Mark Fairchild REGISTER OF DEEDS

Register of Deeds Stamp & File Number

4. Lot No. Recorded Plat
5. Private Claims

I, Ralph W VanRiper, in a field survey on June 9, 1999 do hereby state that under requirements of P.A. 74, Michigan P.A. of 1970, the corner points mentioned in lines 1 and 2 above were in conformance with regulations and rules therefore as required in the current manual of survey instructions of the United States Department of the Interior, Bureau of Land Management or by a decree of a Court of Law and /or that the corner points mentioned in lines 3, 4 and 5 above were in conformance with the rules of the Michigan Board of Land Surveyors or by a Decree of a Court of Law; established, re-established, monumented, recovered, found as expressed below:

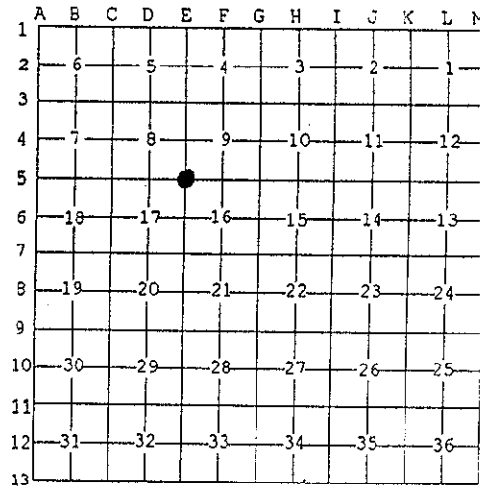

NOTE: Not more than 2 corners, all in the same town and range, may be recorded on this certificate.

A. Description of original monument and accessories and/or subsequent restoration:

1837 GLO set Post Corner of Section 8, 9, 16 & 17

1925 Muskegon County Road Commission: Iron Rod; NE T Pole 33.3'; SW 12" Maple 36.5'; SSW Tree 37.35'; WSW Tree 57.85'

Muskegon County Road Commission - Old Witness Sheet shows nothing at Corner; Current Witness Book shows - SE 43.05' T.P.; SW 39.34' Ash; NE 101.00 T.P.

B. Description of corner evidence found and/or method applied in restoring or reestablishing corner:

Found 1" Pipe over 1/2" Pipe in Monument Box in Moorland Road at Cline Road

Historical usage, documentation and evidence of corner location reviewed and ratified by Muskegon County Peer Group 5/11/99

POSITION OF SAID RECORDED CORNER REVIEWED & RATIFIED BY MUSKEGON COUNTY PEER GROUP IN ACCORDANCE WITH P.A. 345, OF 1990 SW 5/11/99

C. Description of monument for corner and accessories established to perpetuate locating the position of the corner:

Set 2 3/4" Cast Iron "County Survey" Monument in Monument Box

- N 58° W 73.09' Found Nail in S side of Power Pole
N 32° W 189.27' Set Nail in NE side of 12" Maple
N 16° E 112.12' Found Nail in E side of Telephone Pole
N 83° E 309.46' Found Nail in S side of Power Pole
S 13° W 140.01' Set Nail in E side of Wood Fence Post
S 04° E 421.96' Set PK Nail in W side of Service Pole



Signed by [Signature] 16946
Surveyor's Michigan License No.

Date Dec. 22, 1999