

FEB 09 2000

LIST: 2327 PAGE 697

STATE OF MICHIGAN
COUNTY OF MUSKEGON
RECEIVED FOR RECORD

SECTION

LAND CORNER RECORDATION CERTIFICATE
Filing Requirement of Act 74, Mich. P.A. 1970

DEC 29 AM 8:37

For corners in

Muskegon (County)	Located In:	Corner Code #
1. Public Land Survey	T 9N R 14W	F-2
	T ___ R ___	___
	T ___ R ___	___
	T ___ R ___	___
2. Property Controlling in Section	S ___ T ___ R ___	___
	S ___ T ___ R ___	___
3. Miscellaneous Property in Sec.	S ___ T ___ R ___	___
	S ___ T ___ R ___	___


Mark Fairchild
REGISTER OF DEEDS

Register of Deeds Stamp & File Number

4. Lot No. _____, Recorded Plat _____
5. Private Claims _____

I, Ralph W VanRiper, in a field survey on June 30, 1999 do hereby state that under requirements of P.A. 74, Michigan P.A. of 1970, the corner points mentioned in lines 1 and 2 above were in conformance with regulations and rules therefore as required in the current manual of survey instructions of the United States Department of the Interior, Bureau of Land Management or by a decree of a Court of Law and /or that the corner points mentioned in lines 3, 4 and 5 above were in conformance with the rules of the Michigan Board of Land Surveyors or by a Decree of a Court of Law; established, re-established, monumented, recovered, found as expressed below:

NOTE: Not more than 2 corners, all in the same town and range, may be recorded on this certificate.

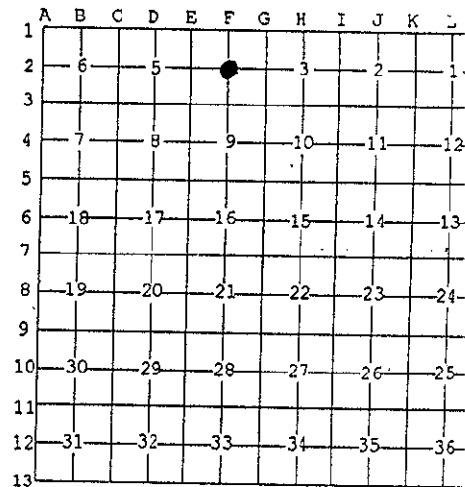

A. Description of original monument and accessories and/or subsequent restoration:

CENTER OF SECTION 4 - NOT SET BY GLO

1927 Muskegon County Road Commission found a "Ford Axle"

Muskegon County Old Witness Sheets and Current Witness Books shows - Wood Stake & Stones: NW 60.40' Tel. Pole; SW 37.32' Tel. Pole; SE 50.15' 3" Elm

B. Description of corner evidence found and/or method applied in restoring or reestablishing corner:

Found 1" Square Headed Bolt in Rock Cluster in Gravel of Wunsch Road

Historical usage, documentation and evidence of corner location reviewed and ratified by Muskegon County Peer Group 5/11/99

C. Description of monument for corner and accessories established to perpetuate locating the position of the corner:

Set 2 3/4" Cast Iron "County Survey" Monument


S 80° W 24.18' Set Nail in S side of Elm Cluster
NOTHING ELSE AVAILABLE TO WITNESS TO

Half Mile distance to 1/4 Corner to the North = 2670.15'

Half Mile distance to 1/4 Corner to the South = 2643.24'

Angle at Center of Section from N to S by way of W = 180°21'50"

POSITION OF SAID
RECORDED CORNER
REVIEWED & RATIFIED
BY MUSKEGON COUNTY
PEER GROUP IN ACCORDANCE
OF ACT 245 OF 1990
*SVV
5/11/99*

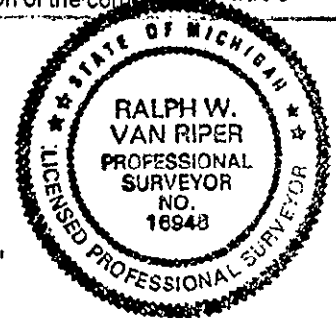

Signed by Ralph W. VanRiper
Surveyor's Michigan License No. 16948

Date Dec. 22, 1999

A2096