

FEB 09 2000

LIBER 2327 PAGE 699

STATE OF MICHIGAN
COUNTY OF MUSKEGON
RECEIVED FOR RECORD

899
DEC 29 AM 8:37

SECTION

LAND CORNER RECORDATION CERTIFICATE
Filing Requirement of Act 74, Mich. P.A. 1970

For corners in

<u>Muskegon</u> (County)	Located In:	Corner Code #
1. Public Land Survey	T <u>9</u> N R <u>14</u> W	<u>F-4</u>
	T ___ R ___	_____
	T ___ R ___	_____
	T ___ R ___	_____
2. Property Controlling in Section	S ___ T ___ R ___	_____
	S ___ T ___ R ___	_____
3. Miscellaneous Property in Sec.	S ___ T ___ R ___	_____
	S ___ T ___ R ___	_____

Mark Fairchild
REGISTER OF DEEDS

Register of Deeds Stamp & File Number

4. Lot No. _____, Recorded Plat _____
5. Private Claims _____

I, Ralph W VanRiper, in a field survey on Aug. 5, 1999 do hereby state that under requirements of P.A. 74, Michigan P.A. of 1970, the corner points mentioned in lines 1 and 2 above were in conformance with regulations and rules therefore as required in the current manual of survey instructions of the United States Department of the Interior, Bureau of Land Management or by a decree of a Court of Law and /or that the corner points mentioned in lines 3, 4 and 5 above were in conformance with the rules of the Michigan Board of Land Surveyors or by a Decree of a Court of Law; established, re-established, monumented, recovered, found as expressed below:

NOTE: Not more than 2 corners, all in the same town and range, may be recorded on this certificate.

1	A	B	C	D	E	F	G	H	I	J	K	L
2		6		5		4		3		2		1
3												
4		7		8		●		10		11		12
5												
6		18		17		16		15		14		13
7												
8		19		20		21		22		23		24
9												
10		30		29		28		27		26		25
11												
12		31		32		33		34		35		36
13												

A. Description of original monument and accessories and/or subsequent restoration:

CENTER OF SECTION 9 - NOT SET BY GLO

Muskegon County Road Commission - Old Witness Sheets and Current Witness Book show nothing at this Corner

B. Description of corner evidence found and/or method applied in restoring or reestablishing corner:

SET CENTER OF SECTION AT INTERSECTION OF 1/4 LINES


Approved by Muskegon County Peer Group 5/11/99

POSITION OF SAID
RECORDED CORNER
REVIEWED & RATIFIED
MUSKEGON COUNTY
BOARD OF SURVEYORS IN ACCORDANCE
WITH P.A. 74, OF 1970

C. Description of monument for corner and accessories established to perpetuate locating the position of the corner:

Set 2 3/4" Cast Iron "County Survey" Monument

- N 86° E 204.91' Set Nail in S side of 12" Birch
- S 69° E 57.68' Set Nail in SW side of 6" Tree
- N 57° E 53.20' Set Nail in SE side of 8" Birch
- N 01° W 37.32' Set Nail in E side of 8" Birch
- N 76° W 62.59' Set Nail in N side of 4" Poplar
- S 63° W 308.90' Set Nail in N side of Power Pole

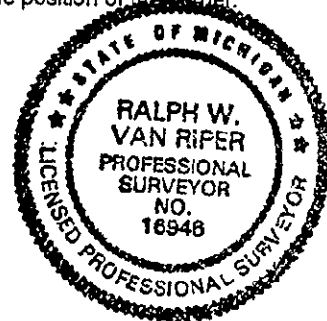

Signed by Ralph W. Van Riper
Surveyor's Michigan License No. 16946

Date Dec. 22, 1999