

SURVEY & REMONUMENTATION

LIBER **2324** PAGE **875**

FEB 09 2000

SECTION

1999 DEC 16 AM 11:02

Mark Fairchild

Muskegon County
Register of Deeds
Muskegon, Michigan

LAND CORNER RECORDATION CERTIFICATE
Filing Requirement of Act 74, Mich. P.A. 1970

For corners in

Muskegon (County)	Located In:	Corner Code #
1. Public Land Survey	T <u>9N</u> R <u>14W</u>	<u>F-9</u>
	T _____ R _____	_____
	T _____ R _____	_____
	T _____ R _____	_____
2. Property Controlling In Section	S _____ T _____ R _____	_____
	S _____ T _____ R _____	_____
3. Miscellaneous Property in Sec.	S _____ T _____ R _____	_____
	S _____ T _____ R _____	_____
4. Lot No. _____, Recorded Plat _____		
5. Private Claims _____		

Register of Deeds Stamp & File Number

I, Stephen V. Vallier, in a field survey on September, 1999, do hereby state that under requirements of P.A. 74, Michigan P.A. of 1970, the corner points mentioned in lines 1 and 2 above were in conformance with regulations and rules therefore as required in the current manual of survey instructions of the United States Department of the Interior, Bureau of Land Management or by a decree of a Court of Law and for that the corner points mentioned in lines 3, 4 and 5 above were in conformance with the rules of the Michigan Board of Land Surveyors or by a Decree of a Court of Law; established, re-established, monumented, recovered, found as expressed below:

NOTE: Not more than 2 corners, all in the same town and range, may be recorded on this certificate.

A. Description of original monument and accessories and/or subsequent restoration:

- 1837 GLO (John Millett) set the quarter section post.
N 48° E 14 Links 10" Beech
S 09° W 14 Links 9" Sugar
- 1888 C. S. Gamble, Deputy County Surveyor, shows corner on a road survey - no witness.
- 1891 H. Vanzinlinger, Deputy County Surveyor, shows corner 86' north and 32' east of the road intersection.
N 43° W 28.5' 61" Elm
N 21° W 70.0' 70" Oak
The distance to the southwest corner is 2634' and the distance to the southeast corner is 2682.
- 1950's M.C.R.C. found a bent iron and replaced it with a 1/2" iron rod.
NE 43.3' Telephone Riser
ESE 99.91' 6" Elm
NNW 119.2' 20" Elm
NW 49.18' Corner Fence Post
NNE 111.50' 30" Elm
SE 45.1 Corner Fence Post

	A	B	C	D	E	F	G	H	I	J	K	L	M
1													
2	6	5	4	3	2	1							
3													
4	7	8	9	10	11	12							
5													
6	18	17	16	15	14	13							
7													
8	19	20	21	22	23	24							
9													
10	30	29	28	27	26	25							
11													
12	31	32	33	34	35	36							
13													

POSITION OF SAID
RECORDED CORNER
REVIEWED & RATIFIED *sw* 7/13/99
BY MUSKEGON COUNTY
PEER GROUP IN ACCORDANCE
WITH P.A. 345, OF 1990

B. Description of corner evidence found and/or method applied in restoring or reestablishing corner:

Found a 1/2" x 18" iron rod and a 1/2" x 13" iron rod next to a pointed rock with a chiseled square. Found adjacent to this was broken crockery and glass. All physical evidence was found at the intersection of the existing roads. Measured a distance of 1881' to investigate a possible double corner position. No evidence of a second corner or occupation was found. Accepted position of the corner due to historical usage and documentation.

- N 40° E 43.32' Telephone Riser
- N 10° W 118.82' 20" Elm


C. Description of monument for corner and accessories established to perpetuate locating the position of the corner:

Accepted the position of a found 1/2" iron rod and reset with a 2 3/4" cast-iron Monument with a county surveyor's cap.

- N 55° W 58.73' 8" Elm Set nail in south side
- N 11° W 81.42' 10" Oak Set nail in east side
- N 20° E 99.79' 10" Oak Set nail in west side
- N 81° E 105.67' 10" Elm Set nail in south side
- N 10° W 118.82' 20" Elm Set nail in east side
- N 40° E 43.32' Telephone Riser

Signed by *Stephen V. Vallier*
Surveyor's Michigan License No. 28428

Date 12/17/99

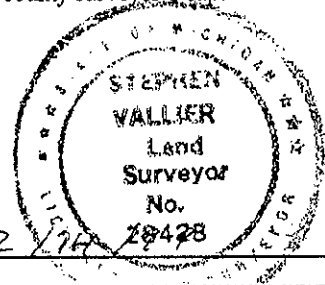

A 2046