

SURVEY &
REMONUMENTATION

FEB 09 2000

SECTION

1999 DEC 16 AM 11:02

Mark F. Fairchild

Muskegon County
Register of Deeds
Muskegon, Michigan

LAND CORNER RECORDATION CERTIFICATE
Filing Requirement of Act 74, Mich. P.A. 1970

For corners in

Muskegon (County)	Located in:	Corner Code #
1. Public Land Survey	T <u>9N</u> R <u>14W</u>	<u>F-12</u>
	T _____ R _____	_____
	T _____ R _____	_____
	T _____ R _____	_____
2. Property Controlling In Section	S _____ T _____ R _____	_____
	S _____ T _____ R _____	_____
3. Miscellaneous Property in Sec.	S _____ T _____ R _____	_____
	S _____ T _____ R _____	_____

Register of Deeds Stamp & File Number

4. Lot No. _____ Recorded Plat _____
5. Private Claims _____

I, Stephen V. Vallier, in a field survey on November, 1999, do hereby state that under requirements of P.A. 74, Michigan P.A. of 1970, the corner points mentioned in lines 1 and 2 above were in conformance with regulations and rules therefore as required in the current manual of survey instructions of the United States Department of the Interior, Bureau of Land Management or by a decree of a Court of Law and /or that the corner points mentioned in lines 3, 4 and 5 above were in conformance with the rules of the Michigan Board of Land Surveyors or by a Decree of a Court of Law; established, re-established, monumented, recovered, found as expressed below:

	A	B	C	D	E	F	G	H	I	J	K	L	M
1													
2	6		5		4		3		2		1		
3													
4	7		8		9		10		11		12		
5													
6	18		17		16		15		14		13		
7													
8	19		20		21		22		23		24		
9													
10	30		29		28		27		26		25		
11													
12	31		32		33		34		35		36		
13													

NOTE: Not more than 2 corners, all in the same town and range, may be recorded on this certificate.

A. Description of original monument and accessories and/or subsequent restoration:

Corner not set by G.L.O.

1977 D. Bonnema set a 1/2" rod at the intersection of 1/4 lines. Fence corners are 2.2' north and 7.3' west. L.C.R.C. is recorded in Liber 1112, Page 723.
SSW 36.90' Nail in side of fence post
NNE 60.17' Nail in side of fence post

POSITION OF SAID
RECORDED CORNER
REVIEWED & RATIFIED
BY MUSKEGON COUNTY
PEER GROUP IN ACCORDANCE
WITH P.A. 345, OF 1990

B. Description of corner evidence found and/or method applied in restoring or reestablishing corner:

Found a 1/2" iron rod on the occupation lines described in L.C.R.C., Liber 1112, Page 723. Accepted method of establishment by intersection of 1/4 lines.


C. Description of monument for corner and accessories established to perpetuate locating the position of the corner:

Reset 2 3/4" x 30" cast-iron Monument with county surveyor cap in place of the 1/2" iron rod recorded in Liber 1112, Page 723.

N 00° E 10.00' Set 1/2" iron rod
N 90° W 10.00' Set 1/2" iron rod
N 90° E 10.00' Set 1/2" iron rod
S 00° W 10.00' Set 1/2" iron rod

Signed by *Stephen V. Vallier*
Surveyor's Michigan License No. 28428

Date 12/14/99
28428

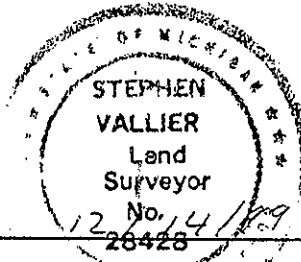

D-2044