

**SURVEY &
REMONUMENTATION**

LIBER **2324** PAGE **872**

FEB 09 2000

SECTION

1999 DEC 16 AM 11:02

Mark F Fairchild

Muskegon County
Register of Deeds
Muskegon, Michigan

LAND CORNER RECORDATION CERTIFICATE
Filing Requirement of Act 74, Mich. P.A. 1970

For corners in

<u>Muskegon</u> (County)	Located In:	Corner Code #
1. Public Land Survey	T <u>9N</u> R <u>14W</u>	<u>F-13</u>
	T _____ R _____	_____
	T _____ R _____	_____
	T _____ R _____	_____
2. Property Controlling In Section	S _____ T _____ R _____	_____
	S _____ T _____ R _____	_____
3. Miscellaneous Property in Sec.	S _____ T _____ R _____	_____
	S _____ T _____ R _____	_____
4. Lot No. _____	Recorded Plat _____	
5. Private Claims _____		

Register of Deeds Stamp & File Number

I, Stephen V. Vallier, in a field survey on November, 1999, do hereby state that under requirements of P.A. 74, Michigan P.A. of 1970, the corner points mentioned in lines 1 and 2 above were in conformance with regulations and rules therefore as required in the current manual of survey instructions of the United States Department of the Interior, Bureau of Land Management or by a decree of a Court of Law and /or that the corner points mentioned in lines 3, 4 and 5 above were in conformance with the rules of the Michigan Board of Land Surveyors or by a Decree of a Court of Law; established, re-established, monumented, recovered, found as expressed below:

NOTE: Not more than 2 corners, all in the same town and range, may be recorded on this certificate.

	A	B	C	D	E	F	G	H	I	J	K	L	M
1													
2	6		5		4		3		2		1		
3													
4	7		8		9		10		11		12		
5													
6	18		17		16		15		14		13		
7													
8	19		20		21		22		23		24		
9													
10	30		29		28		27		26		25		
11													
12	31		32		33		34		35		36		

POSITION OF SAID
RECORDED CORNER *sw*
REVIEWED & RATIFIED: *7/13/99*
BY MUSKEGON COUNTY
PEER GROUP IN ACCORDANCE
WITH P.A. 345, OF 1990

A. Description of original monument and accessories and/or subsequent restoration:

1837 G.L.O. (John Mullett) set quarter section post.
N 32° E 11 Links 13" Elm
N 27° W 22 Links 12" Elm


1977 Carl Englert set 5/8" iron rod halfway between section line. L.C.R.C. is recorded in Liber 1118, Page 940.
SW 107.41' Power Pole
WNW 145.13' Power Pole
NW 125.73' Southeast corner/house foundation

B. Description of corner evidence found and/or method applied in restoring or reestablishing corner:

Found a 5/8"x 18" iron rod at the centerline of Wilson Road The method of reestablishment as lost corner by single-proportionate measure was accepted. Documentation and evidence was un-supportive of G.L.O. perpetuation.
N 40° W 125.27' Found at the Southeast corner of house
S 57° W 107.33' Power Pole

C. Description of monument for corner and accessories established to perpetuate locating the position of the corner:

Reset with a 2 3/4"x30" cast-iron Monument with county surveyor cap in place of the 5/8"x 18" iron rod recorded in Liber 1118, Page 940.
S 57° W 107.33' Power Pole Found nail in the southeast side
S 75° W 91.86' Power Pole Found nail in the west side
N 69° W 125.04' Power Pole Found nail in the north side
N 40° W 125.27' Southeast corner of house No. 10770
N 77° E 293.30' 40" Stump Found nail in the south side
S 73° E 298.21' Power Pole Set 20d nail in the south side

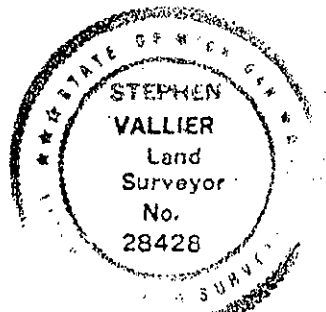

Signed by *Stephen Vallier*
Surveyor's Michigan License No. 28428

Date 12/14/99

A2043