

MAR 09 1999

STATE OF MICHIGAN
COUNTY OF MUSKEGON
RECEIVED FOR RECORD

SECTION

LAND CORNER RECORDATION CERTIFICATE
Filing Requirement of Act 74, Mich. P.A. 1970

1998 DEC 29 PM 4:24

For corners in

Muskegon (County)	Located In:	Corner Code #
1. Public Land Survey	T 9N R 14W	G-3
	T R	
	T R	
	T R	
2. Property Controlling in Section	S T R	
	S T R	
3. Miscellaneous Property in Sec.	S T R	
	S T R	

Carrie Carter
REGISTER OF DEEDS

LIBER 2189 PAGE 821

Register of Deeds Stamp & File Number

4. Lot No. _____, Recorded Plat _____
5. Private Claims _____

I, Ralph W VanRiper, in a field survey on Oct. 15, 1998 do hereby state that under requirements of P.A. 74, Michigan P.A. of 1970, the corner points mentioned in lines 1 and 2 above were in conformance with regulations and rules therefore as required in the current manual of survey instructions of the United States Department of the Interior, Bureau of Land Management or by a decree of a Court of Law and for that the corner points mentioned in lines 3, 4 and 5 above were in conformance with the rules of the Michigan Board of Land Surveyors or by a Decree of a Court of Law; established, re-established, monumented, recovered, found as expressed below:

NOTE: Not more than 2 corners, all in the same town and range, may be recorded on this certificate.

	A	B	C	D	E	F	G	H	I	J	K	L	M
1													
2	6		5		4		3		2		1		
3							●						
4	7		8		9		10		11		12		
5													
6	18		17		16		15		14		13		
7													
8	19		20		21		22		23		24		
9													
10	30		29		28		27		26		25		
11													
12	31		32		33		34		35		36		
13													

A. Description of original monument and accessories and/or subsequent restoration:

Section Corner common to Sections 3, 4, 9 and 10, T9N, R14W

Post set by GLO Surveyors in 1837 : Beach 6" S39°E 24L & Lynn 36" S75°E 12L

MCRC 1950's Witness Map : RR Spike : N 32.9' 8" Pop.- SE 43.70' T.P. - SW 45.90' Corn.F Post

Current MCRC Witness Book shows 1" Iron Mon Box.: SE 54.69' St. Sign.: SW 63.80' Tel.P NE 71.14' P. P. - Rec. L-1118, P-938 by C P Englert & L-1230, P365 by R W VanRiper

B. Description of corner evidence found and/or method applied in restoring or reestablishing corner:

Found 1" Pipe in Monument Box and accepted corner based on Historical usage and documentation


*SW
2/7/98*

POSITION OF SAID
RECORDED CORNER
REVIEWED & RATIFIED
BY MUSKEGON COUNTY
PEER GROUP IN ACCORDANCE
WITH P.A. 345, OF 1990

C. Description of monument for corner and accessories established to perpetuate locating the position of the corner:

Set 2 3/4" Cast Iron Monument with County Survey Cap in Monument Box

- N 34° E 71.13' Found Spike in E Side of Power Pole
- N 06° E 85.33' Found Spike in E Side of 14" Ash
- N 45° W 199.12' Set Spike in SW Side of 14" Willow
- N 77° W 350.65' Set "PK" Nail in N Side of Power Pole
- N 70° E 193.45' Set Spike in S Side of 24" Ash
- S 08° E 163.95' Found Spike in W Side of Power Pole

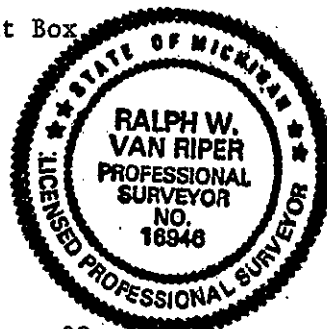

Signed by *Ralph W. Van Riper*
Surveyor's Michigan License No. 16946

Date Dec. 23, 1998

A1998