

MAR 09 1999

LAND CORNER RECORDATION CERTIFICATE
Filing Requirement of Act 74, Mich. P.A. 1970

STATE OF MICHIGAN
COUNTY OF MUSKEGON
RECEIVED FOR RECORD

1998 DEC 29 PM 4:24

Carrie Carter
REGISTER OF DEEDS

For corners in SECTION

Muskegon (County)	Located In:	Corner Code #
1. Public Land Survey	T <u>9</u> N R <u>14</u> W	<u>G-4</u>
	T ___ R ___	___
	T ___ R ___	___
	T ___ R ___	___
2. Property Controlling in Section	S ___ T ___ R ___	___
	S ___ T ___ R ___	___
3. Miscellaneous Property in Sec.	S ___ T ___ R ___	___
	S ___ T ___ R ___	___

LIBER 2189 PAGE 822

Register of Deeds Stamp & File Number

4. Lot No. _____, Recorded Plat _____
5. Private Claims _____

I, Ralph W VanRiper, in a field survey on Dec. 3, 1998 do hereby state that under requirements of P.A. 74, Michigan P.A. of 1970, the corner points mentioned in lines 1 and 2 above were in conformance with regulations and rules therefore as required in the current manual of survey instructions of the United States Department of the Interior, Bureau of Land Management or by a decree of a Court of Law and /or that the corner points mentioned in lines 3, 4 and 5 above were in conformance with the rules of the Michigan Board of Land Surveyors or by a Decree of a Court of Law; established, re-established, monumented, recovered, found as expressed below:

NOTE: Not more than 2 corners, all in the same town and range, may be recorded on this certificate.

	A	B	C	D	E	F	G	H	I	J	K	L	M
1													
2	6		5		4		3		2		1		
3													
4	7		8		9		10		11		12		
5													
6	18		17		16		15		14		13		
7													
8	19		20		21		22		23		24		
9													
10	30		29		28		27		26		25		
11													
12	31		32		33		34		35		36		
13													

A. Description of original monument and accessories and/or subsequent restoration:

Quarter Corner between Sections 9 and 10, T 9 N, R 14 W
Post set by GLO Surveyors in 1837 : Sugar 8" S19°W 7L & Ironwood 6" N60°E 14L

MCRC 1950's Witness Map shows "Centerline of R.R.Track"

Current MCRC Witness Book shows : 1/2 Iron - N11°E 173.41' P.P. - N71°W 55.17' 4" Tw Elm - S62° W 140.71 NE Leg of Steel Trans Tower - S 33° E 59.41 P.P. - S 2.74' Inside edge N Rail - NW 24.29' RR Marker - SE 27.03' RR Marker - LCRC L-1118, P938 by C P Englert - LCRC L-1645, P-199 and L-1670, P-792 by S J Kass

B. Description of corner evidence found and/or method applied in restoring or reestablishing corner:

Reset corner based on Section Notes of C F Lewandoski and Moore & Bruggink
Information from Haymeadow Subdivision Information. Set corner is 1.80' East of Corner as set in LCRC L-1670, P-792


sw
7/7/98

POSITION OF SAID
RECORDED CORNER
REVIEWED & RATIFIED
BY MUSKEGON COUNTY
PEER GROUP IN ACCORDANCE
WITH P.A. 345, OF 1990

C. Description of monument for corner and accessories established to perpetuate locating the position of the corner:

Set 2 3/4 Cast Iron Monument with County Survey Cap

- N 12° E 173.65' Found Spike in E side of Power Pole
- N 52° E 69.13' Set Spike in NW side of 4" Elms
- S 34° E 60.45' Found Spike in SW side of Power Pole
- S 14° E 141.57' Set "PK" Nail in W side of Power Pole
- N 70° W 87.26' Set Spike in N side of 6" Elm
- S 61° W 139.57' NE Corner Leg of Steel Tower (0.7' above ground)

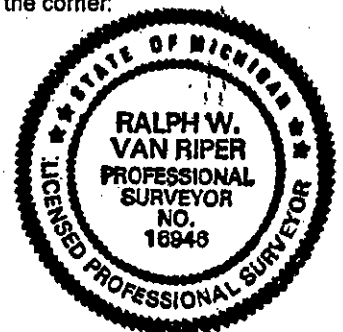

Signed by *Ralph W. Van Riper*
Surveyor's Michigan License No. 16946

Date Dec. 23, 1998

Office

A 1999