

FEB 09 2000

1999 DEC 16 AM 11:04

SECTION

*Mark F. Harshbarger*

Muskegon County  
Register of Deeds  
Muskegon, Michigan

LAND CORNER RECORDATION CERTIFICATE  
Filing Requirement of Act 74, Mich. P.A. 1970

For corners in

<u>Muskegon</u> (County)	Located In:	Corner Code #
1. Public Land Survey	T <u>9N</u> R <u>14W</u>	<u>G-8</u>
	T _____ R _____	_____
	T _____ R _____	_____
	T _____ R _____	_____
2. Property Controlling In Section	S _____ T _____ R _____	_____
	S _____ T _____ R _____	_____
3. Miscellaneous Property in Sec.	S _____ T _____ R _____	_____
	S _____ T _____ R _____	_____
4. Lot No. _____	Recorded Plat _____	
5. Private Claims _____		

Register of Deeds Stamp & File Number

I, Stephen V. Vallier, in a field survey on November 11, 1999, do hereby state that under requirements of P.A. 74, Michigan P.A. of 1970, the corner points mentioned in lines 1 and 2 above were in conformance with regulations and rules therefore as required in the current manual of survey instructions of the United States Department of the Interior, Bureau of Land Management or by a decree of a Court of Law and /or that the corner points mentioned in lines 3, 4 and 5 above were in conformance with the rules of the Michigan Board of Land Surveyors or by a Decree of a Court of Law; established, re-established, monumented, recovered, found as expressed below:

NOTE: Not more than 2 corners, all in the same town and range, may be recorded on this certificate.

	A	B	C	D	E	F	G	H	I	J	K	L	I
1													
2	6		5		4		3		2		1		
3													
4	7		8		9		10		11		12		
5													
6	18		17		16		15		14		13		
7													
8	19		20		21		22		23		24		
9													
10	30		29		28		27		26		25		
11													
12	31		32		33		34		35		36		
13													

A. Description of original monument and accessories and/or subsequent restoration:

1837 G.L.O. (John Mullett) set the quarter section post.  
S 18° W 12 Links 8" Ironwood  
N 58° E 5 Links 6" Ironwood

1891 County Surveyor, VanZinglinger, set stone, no witnesses.  
(Last record of corner)

*sv*  
*7/13/99*

POSITION OF SAID  
RECORDED CORNER  
REVIEWED & RATIFIED  
BY MUSKEGON COUNTY  
PEER GROUP IN ACCORDANCE  
WITH P.A. 345, OF 1990


B. Description of corner evidence found and/or method applied in restoring or reestablishing corner:

Found a buggy axle with crockery and glass 1.3' deep in a farm field that checks within 11' of the 1891 prorated measure for mile. It is believed that the corner monument is true and correct with the position of the 1891 reestablishment of the corner, which is a perpetuation of the 1837 G.L.O. corner.

C. Description of monument for corner and accessories established to perpetuate locating the position of the corner:

Reset with a county surveyor's 2 3/4" x 30" cast-iron monument in the place of the found buggy axle (approximately 1' deep in furrowed field.)

N 8°	E	102.40'	8" Elm	Set rod nail on the west side
N 54°	E	180.68'	12" Maple	Set rod nail on the southeast side
S 85°	E	376.68'	10" Oak	Set rod in the south side
N 32°	W	361.74'	16" Hickory	Set rod in the northeast side
N 75°	W	186.34'	6" Hickory	Set rod in the southwest side

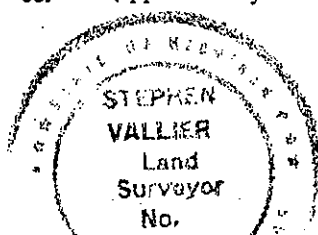

Signed by *Stephen V. Vallier*  
Surveyor's Michigan License No. 28428

Date *Dec 28 1999*

*A.2054*