

**SURVEY &
REMONUMENTATION**

LIBER 2324 PAGE 878

FEB 09 2000

SECTION

1999 DEC 16 AM 11:03

Mark Fairchild

Muskegon County
Register of Deeds
Muskegon, Michigan

LAND CORNER RECORDATION CERTIFICATE
Filing Requirement of Act 74, Mich. P.A. 1970

For corners in

<u>Muskegon</u> (County)	Located In:	Corner Code #
1. Public Land Survey	T <u>9N</u> R <u>14W</u>	<u>G-12</u>
	T _____ R _____	_____
	T _____ R _____	_____
	T _____ R _____	_____
2. Property Controlling In Section	S _____ T _____ R _____	_____
	S _____ T _____ R _____	_____
3. Miscellaneous Property in Sec.	S _____ T _____ R _____	_____
	S _____ T _____ R _____	_____
4. Lot No. _____, Recorded Plat _____		
5. Private Claims _____		

Register of Deeds Stamp & File Number

I, Stephen V. Vallier, in a field survey on December, 1999, do hereby state that under requirements of P.A. 74, Michigan P.A. of 1970, the corner points mentioned in lines 1 and 2 above were in conformance with regulations and rules therefore as required in the current manual of survey instructions of the United States Department of the Interior, Bureau of Land Management or by a decree of a Court of Law and /or that the corner points mentioned in lines 3, 4 and 5 above were in conformance with the rules of the Michigan Board of Land Surveyors or by a Decree of a Court of Law; established, re-established, monumented, recovered, found as expressed below:

NOTE: Not more than 2 corners, all in the same town and range, may be recorded on this certificate.

	A	B	C	D	E	F	G	H	I	J	K	L	M
1													
2	6		5		4		3		2		1		
3													
4	7		8		9		10		11		12		
5													
6	18		17		16		15		14		13		
7													
8	19		20		21		22		23		24		
9													
10	30		29		28		27		26		25		
11													
12	31		32		33		34		35		36		
13													

A. Description of original monument and accessories and/or subsequent restoration:

1837 G.L.O. (John Mullett) set the quarter section post.
N 48° W 8 Links 6" Beech
S 89° E 37 Links 6" Beech

1977 D. Bonnsma, after digging and not finding anything, set a 1/2" capped, solid rod at mid point on line with the section corner.
L.C.R.C. is recorded in Liber 1112, Page 723,
SW 25.54' 12" Twin Maple Nail in the side
NW 24.75' 12" Maple Nail in the side
SE 28.08 12" Maple Nail in the side


POSITION OF SAID
RECORDED CORNER *sw*
REVIEWED & RATIFIED *7/13/99*
BY MUSKEGON COUNTY
PEER GROUP IN ACCORDANCE
WITH P.A. 345, OF 1999

B. Description of corner evidence found and/or method applied in restoring or reestablishing corner:

Found a 1/2" capped-iron rod in the center line of an unimproved road. Accepted the 1977 retracement and reestablishment as lost corner by single-proportionate method. Documentation is un-supportive of G.L.O. perpetuation.
S 48° W 25.55' 26" Twin Cherry Found nail in the south side
N 53° W 24.35' 18" Maple Found nail in the south side

C. Description of monument for corner and accessories established to perpetuate locating the position of the corner:

Set a 2 3/4" x 30" cast-iron monument in place of the accepted 1/2" capped iron rod.
S 48° W 25.55' 26" Twin Cherry Found nail in the south side
S 53° W 24.35' 18" Maple Found nail in the south side
S 20° W 63.35' 14" Twin Maple Found nail in the east side
S 58° E 52.45' 10" Maple Set nail in the south side
S 85° E 53.70' 12" Maple Set nail in the south side
N 19° E 46.91' 10" Maple Set nail in the west side

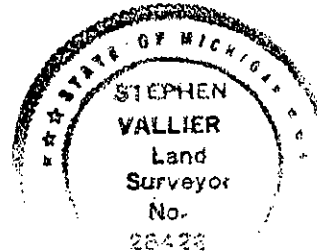

Signed by *Stephen V. Vallier*
Surveyor's Michigan License No. 28428

Date 12/14/99

A2049