

**SURVEY &
REMONUMENTATION**

LIBER 2324 PAGE 876

FEB 09 2000

SECTION

1999 DEC 16 AM 11:03

Mark F. Fairchild

Muskegon County
Register of Deeds
Muskegon, Michigan

LAND CORNER RECORDATION CERTIFICATE
Filing Requirement of Act 74, Mich. P.A. 1970

For corners in

<u>Muskegon</u> (County)	Located In:	Corner Code #
1. Public Land Survey	T <u>9N</u> R <u>14W</u>	<u>H-9</u>
	T _____ R _____	_____
	T _____ R _____	_____
	T _____ R _____	_____
2. Property Controlling In Section	S _____ T _____ R _____	_____
	S _____ T _____ R _____	_____
3. Miscellaneous Property in Sec.	S _____ T _____ R _____	_____
	S _____ T _____ R _____	_____
4. Lot No. _____, Recorded Plat _____		
5. Private Claims _____		

Register of Deeds Stamp & File Number

I, Stephen V. Vallier, in a field survey on November, 1999, do hereby state that under requirements of P.A. 74, Michigan P.A. of 1970, the corner points mentioned in lines 1 and 2 above were in conformance with regulations and rules therefore as required in the current manual of survey instructions of the United States Department of the Interior, Bureau of Land Management or by a decree of a Court of Law and /or that the corner points mentioned in lines 3, 4 and 5 above were in conformance with the rules of the Michigan Board of Land Surveyors or by a Decree of a Court of Law; established, re-established, monumented, recovered, found as expressed below:

	A	B	C	D	E	F	G	H	I	J	K	L
1												
2	6		5		4		3		2		1	
3												
4	7		8		9		10		11		12	
5												
6	18		17		16		15		14		13	
7												
8	19		20		21		22		23		24	
9												
10	30		29		28		27		26		25	
11												
12	31		32		33		34		35		36	
13												

NOTE: Not more than 2 corners, all in the same town and range, may be recorded on this certificate.

A. Description of original monument and accessories and/or subsequent restoration:

- 1837 G.L.O. (John Millett) set the quarter section post.
S 59° E 25 Links 12" Elm
N 49° W 34 Links 8" Sugar
- 1977 Carl Englert recorded L.C.R.C. in Liber 1118, Page 939 of a found 1" iron.
E 24.46' 7" Tree
SE 29.11 15" Ash
SW 24.45' 6" Elm
WNW 6.10' 3" Willow
- 1977 Carl Englert's land survey is recorded in Liber 1136, Page 969.


POSITION OF SAID
RECORDED CORNER
REVIEWED & RATIFIED
BY MUSKEGON COUNTY
PEER GROUP IN ACCORDANCE
WITH P.A. 345, OF 1990

B. Description of corner evidence found and/or method applied in restoring or reestablishing corner:

Found a 1" iron pipe on the east and west fence line. The position of the corner was accepted due to historical usage. Documentation and evidence un-supportive of G.L.O. perpetuation.
S 75° E 24.66' 12" Elm

C. Description of monument for corner and accessories established to perpetuate locating the position of the corner:

- Reset a 2 3/4"x30" cast-iron monument in place of a found 1" iron pipe.
N 30° E 5.17' 14" Maple Found the nail in the south side
S 28° E 20.36' 18" Elm Found nail in the west side with blaze marks
S 75° E 24.66' 12" Elm Found nail in the northeast side
S 33° W 47.00 14" Elm Found nail in the south side
S 80° W 38.75' 10" Elm Found nail in the north side
N 13° W 15.61' 10" Elm Found nail in the west side

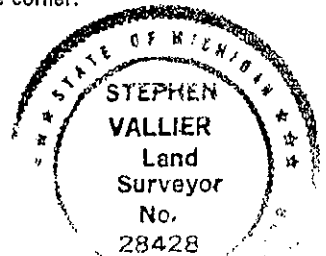

Signed by *Stephen V. Vallier*
Surveyor's Michigan License No. 28428

Date 12/4/99

A.2047