

LAND CORNER RECORDATION CERTIFICATE
Filing Requirement of Act 74, Mich. P.A. 1970

STATE OF MICHIGAN
 COUNTY OF MUSKEGON
 RECEIVED FOR RECORD

For corners in

Muskegon Located In: _____ Corner Code # _____
 (County)

1. Public Land Survey T 9N R 14W 1-7
 T _____ R _____
 T _____ R SURVEY &
 T _____ R REMONUMENTATION
 R _____

2. Property Controlling S _____ T _____
 In Section S _____ T _____ R NOV 28 2000
 3. Miscellaneous S _____ T _____ R _____
 Property in Sec. S _____ T _____ R SECTION

4. Lot No. _____, Recorded Plat _____
 5. Private Claims _____

1998 DEC 23 AM 8:11

Carrie Carter
 REGISTER OF DEEDS

LIBER 2187 PAGE 893

Register of Deeds Stamp & File Number


I, Stanley H. Shackelford, in a field survey on June 18, 1998, do hereby state that under requirements of P.A. 74, Michigan P.A. of 1970, the corner points mentioned in lines 1 and 2 above were in conformance with regulations and rules therefore as required in the current manual of survey instructions of the United States Department of the Interior, Bureau of Land Management or by a decree of a Court of Law and /or that the corner points mentioned in lines 3, 4 and 5 above were in conformance with the rules of the Michigan Board of Land Surveyors or by a Decree of a Court of Law; established, re-established, monumented, recovered, found as expressed below:

NOTE: Not more than 2 corners, all in the same town and range, may be recorded on this certificate.

A	B	C	D	E	F	G	H	I	J	K	L
1											
2	6	5	4	3	2	1					
3											
4	7	8	9	10	11	12					
5											
6	18	17	16	15	14	13					
7											
8	19	20	21	22	23	24					
9											
10	30	29	28	27	26	25					
11											
12	31	32	33	34	35	36					
13											

A. Description of original monument and accessories and/or subsequent restoration:

- 1837 G.L.O. set 12" Sugar at corner. No witnesses taken.
- 1950 M.C.R.C. Tie Book, 1" iron in monument box.
 ENE 70.40' 36" Elm Stump
 SE 44.66' Guy Pole
 SW 43.24' Telephone Pole
- 1977 Recorded by Carl Englert in Liber 1118, page 939, found monument box.
 SW 43.24' Power Pole
 SE 44.66' Guy Pole
- 1977 Survey by Carl Englert, recorded in Liber 1136, page 969, found monument box.
 SW 43.24' Power Pole
 SE 44.66' Guy Pole

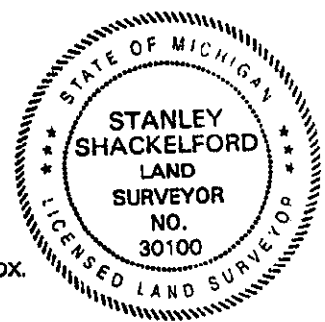

B. Description of corner evidence found and/or method applied in restoring or reestablishing corner:

- I-7 Found 3/4"x17" rod over a pipe 36" deep in monument box. Set 2 3/4" cast-iron monument with county surveyor's cap in monument box. Accepted position of corner due to historical usage and documentation.

S 55° W	45.09'	Power Pole	Found nail in SE side
S 45° E	43.54'	Guy Pole	Set nail in NE side
N 58° W	52.43'	S.C.I.R.	By NW curb at the W end
N 31° E	52.08'	S.C.I.R.	By NE curb at the E end
N 46° E	52.61'	C/L of Street Sign	
S 43° W	51.71'	C/L of Telephone Riser	

June 2, 1998
SW

C. Description of monument for corner and accessories established to perpetuate locating the position of the corner:

- I-7 Set 2 3/4" x 31" cast-iron monument with county surveyors cap in monument box.

S 55° W	45.09'	Power Pole	Found nail in SE side of
S 45° E	43.54'	Guy Pole	Set nail on NE side of
N 58° W	52.43'	S.C.I.R.	By NW curb at the West end
N 31° E	52.08'	S.C.I.R.	By NE curb at the East end
N 46° E	52.61'	C/L of street sign	
S 43° W	51.71'	C/L of telephone riser	

**POSITION OF SAID
 RECORDED CORNER
 REVIEWED & RATIFIED
 BY MUSKEGON COUNTY
 PEER GROUP IN ACCORDANCE
 WITH P.A. 345, OF 1990**

Signed by *Stanley H. Shackelford* Date 12-22-98
 Surveyor's Michigan License No. 30100

A 1968