

FEB 09 2000

SECTION

1999 DEC 16 AM 11: C

Mark F. Finckh

Muskegon County Register of Deeds Muskegon, Michigan

LAND CORNER RECORDATION CERTIFICATE Filing Requirement of Act 74, Mich. P.A. 1970

For corners in

Table with columns: Muskegon (County), Located In: (Town, Range, Section), Corner Code #. Includes entries for Public Land Survey, Property Controlling in Section, and Miscellaneous Property in Sec.

Register of Deeds Stamp & File Number

4. Lot No. Recorded Plat
5. Private Claims

I, Stephen V. Vallier, in a field survey on September 19 99 do hereby state that under requirements of P.A. 74, Michigan P.A. of 1970, the corner points mentioned in lines 1 and 2 above were in conformance with regulations and rules therefore as required in the current manual of survey instructions of the United States Department of the Interior, Bureau of Land Management or by a decree of a Court of Law and /or that the corner points mentioned in lines 3, 4 and 5 above were in conformance with the rules of the Michigan Board of Land Surveyors or by a Decree of a Court of Law; established, re-established, monumented, recovered, found as expressed below:

Grid table with columns A-K and rows 1-13. Contains numbers 6-35 in various cells.

NOTE: Not more than 2 corners, all in the same town and range, may be recorded on this certificate.

A. Description of original monument and accessories and/or subsequent restoration:

- 1837 G.L.O. (John Mullett) set the quarter section post. S 76° E 7 Links 8" Beech
1964 F.F. Smith found a 1" iron pipe. W 69.82' Power Pole NE 76.97' T. Pole with Spike
1997 William Fries found a 1 3/8" O.D. Pipe badly bent. Replaced with a 1/2" iron and cap. The iron is 3" east of occupied C/L of north/south road on a tree row to the east and west. Recorded L.C.R.C. in Liber 1960, Page 49.
AZI Dist. Desc.
32° 57.41' Multiple Ash- Nail in root
25° 111.20' 22" Ash Nail in root
83° 31.24' Telephone Pole
275° 42.51' 17" Ash

POSITION OF SAID RECORDED CORNER REVIEWED & RATIFIED BY MUSKEGON COUNTY DEER GROUP IN ACCORDANCE WITH P.A. 345, OF 1980

B. Description of corner evidence found and/or method applied in restoring or reestablishing corner:


Found a 1/2" x 18" iron rod over a broken 1" iron pipe. Accepted the position of corner due to historical usage and documentation. Perpetuation of the original G.L.O. position was un-supportive.
N 34° E 57.40" 24" Elm Cluster Found nail north side
N 83° E 31.13' Power Pole Found P.K. nail south side

C. Description of monument for corner and accessories established to perpetuate locating the position of the corner:

Found and accepted the position of a 1/2" x 18" iron rod. Replaced with a 2 3/4" x 30" cast-iron monument with a surveyors cap.
N 7° E 337.69' 24" Elm Found nail on north side
N 34° E 57.40' 24" Elm Cluster Found nail on north side
N 41° E 48.75' 12" Elm Cluster Set nail on northwest side
N 63° E 23.69' 20" Elm Cluster Set nail on northside
N 83° E 31.13' P. Pole Found P.K. nail on south side
N 81° W 70.13' P. Pole Set nail on north side

Signed by [Signature] Surveyor's Michigan License No. 28428

Date [Signature] FORM APPROVED BY MICHIGAN STATE BOARD OF PROFESSIONAL SURVEYORS, JAN. 2 REVISED MAY REVISED JAN REVISED OCT

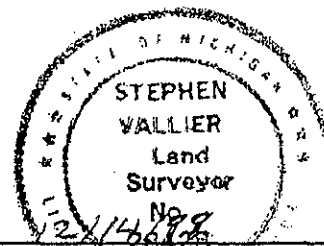

A205