

FEB 09 2000

SECTION

1999 DEC 16 AM 11:03

Mark F. Fairchild

Muskegon County Register of Deeds Muskegon, Michigan

LAND CORNER RECORDATION CERTIFICATE Filing Requirement of Act 74, Mich. P.A. 1970

For corners in

Form with fields for Muskegon (County), Located In: T 9N R 14W, Corner Code # J-11, and sections for Public Land Survey, Property Controlling, Miscellaneous, Lot No., and Private Claims.

Register of Deeds Stamp & File Number

I, Stephen V. Vallier, in a field survey on November 19, 1999, do hereby state that under requirements of P.A. 74, Michigan P.A. of 1970, the corner points mentioned in lines 1 and 2 above were in conformance with regulations and rules...

NOTE: Not more than 2 corners, all in the same town and range, may be recorded on this certificate.

A. Description of original monument and accessories and/or subsequent restoration:

- 1837 G.L.O. (John Mullett) set the quarter section post. N 9° W 23 Links 10" Sugar S 6° W 16 Links 20" beech
1950's M.C.R.C. set a 1" pipe. N 82° W 150.03' 24" Maple S 10° W 26.65' 10" Cherry N 60.35' Power Pole SE 40.88' 36" Elm
1966 William Fries found a 1" O.D. iron pipe on the occupation line north/south and east/west. Az: Distance: 01° 33.00' 1/2" Iron set, Cap #33075 160° 33.71' 10" Ash nail in root 180° 33.00' 1/2" Iron, Cap #30389 256' 93.78' 20" Elm


POSITION OF SAID RECORDED CORNER REVIEWED & RATIFIED BY MUSKEGON COUNTY PEER GROUP IN ACCORDANCE WITH P.A. 345, OF 1990

B. Description of corner evidence found and/or method applied in restoring or reestablishing corner:

Found a 1"x 18" iron pipe on the occupation line, which measured 966' west to the center line of the creek. The G.L.O.'s measurement distance to the creek was 990' (15 chains.) Accepted the position of corner due to historical usage and documentation. S 33° W 26.85' 12" Tri. Cherry

C. Description of monument for corner and accessories established to perpetuate locating the position of the corner:

- Accepted position of the 1" x 18" iron pipe and reset with a 2 3/4" x 30" cast-iron monument with a county surveyors cap. S 32° E 34.02' 12" Elm Nail in the east side S 33° W 26.85' Tri. Cherry Nail in the east side S 56° W 46.43' 12" Elm Nail in the east side S 80° W 93.29' 18" Locust Nail in the east side N 11° W 63.84' Power Pole Nail in the west side N 21° W 30.89' 9" Elm Nail on the east side

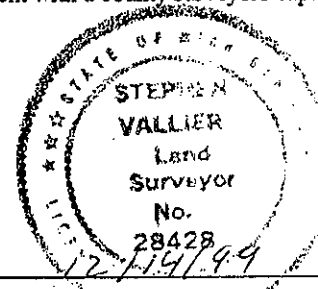

Signed by Stephen V. Vallier Surveyor's Michigan License No. 28428

Date 12/19/99

A.2053