

SURVEY & REMONUMENTATION

FEB 09 2000

SECTION

1999 DEC 16 AM 11:03

Mark Fairchild

Muskegon County
Register of Deeds
Muskegon, Michigan

LAND CORNER RECORDATION CERTIFICATE
Filing Requirement of Act 74, Mich. P.A. 1970

For corners in

<u>Muskegon</u> (County)	Located In:	Corner Code #
1. Public Land Survey	T <u>9 N</u> R <u>14W</u>	<u>J-13</u>
	T _____ R _____	_____
	T _____ R _____	_____
	T _____ R _____	_____
2. Property Controlling In Section	S _____ T _____ R _____	_____
	S _____ T _____ R _____	_____
3. Miscellaneous Property in Sec.	S _____ T _____ R _____	_____
	S _____ T _____ R _____	_____
4. Lot No. _____	Recorded Plat _____	
5. Private Claims _____		

Register of Deeds Stamp & File Number

I, Stephen V. Vallier, in a field survey on November, 1999, do hereby state that under requirements of P.A. 74, Michigan P.A. of 1970, the corner points mentioned in lines 1 and 2 above were in conformance with regulations and rules therefore as required in the current manual of survey instructions of the United States Department of the Interior, Bureau of Land Management or by a decree of a Court of Law and /or that the corner points mentioned in lines 3, 4 and 5 above were in conformance with the rules of the Michigan Board of Land Surveyors or by a Decree of a Court of Law; established, re-established, monumented, recovered, found as expressed below:

NOTE: Not more than 2 corners, all in the same town and range, may be recorded on this certificate.

	A	B	C	D	E	F	G	H	I	J	K	L
1												
2		6		5		4		3		2		1
3												
4		7		8		9		10		11		12
5												
6		18		17		16		15		14		13
7												
8		19		20		21		22		23		24
9												
10		30		29		28		27		26		25
11												
12		31		32		33		34		35		36
13												

A. Description of original monument and accessories and/or subsequent restoration:

- 1837 G.L.O. (John Mullett) set quarter section post.
S 13° W 14 Links 24" Hemlock
N 58° W 10 Links 8" Hemlock
- 1964 M.C.R.C. set the corner by single-proportionate measure.
SE 49.88' 36" Elm
N 60.35' Power Pole

POSITION OF SAID
RECORDED CORNER
REVIEWED & RATIFIED
BY MUSKEGON COUNTY
FEER GROUP IN ACCORDANCE
WITH P.A. 345, OF 1990


sw
6/8/99

B. Description of corner evidence found and/or method applied in restoring or reestablishing corner:

Found a cast-iron monument with a county surveyors cap. Checked proration of the mile for Section 35. The position of corner was accepted due to the historical usage. The documentation of G.L.O. perpetuation is un-supportive.

C. Description of monument for corner and accessories established to perpetuate locating the position of the corner:

- Accepted the 4" cast-iron monument with iron cap, noting "section corner."
- N 75° W 151.15' Power Pole Found P.K. nail in the north side
 - S 38° W 40.92' 6"x6" fencepost Set PK nail in the northwest side
 - S 20° E 53.12' 30" Maple Set 20d Nail in the east side
 - S 04° W 34.49' 6"x6" Fence Post Set 20d Nail in the east side
 - N 04° W 42.76' 10" Willow Set 20d Nail in the east side
 - N 44° E 54.42' 60" Willow Set 20d Nail in the east side

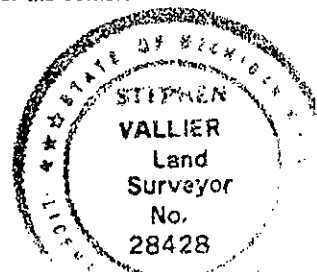

Signed by *Stephen V. Vallier*
Surveyor's Michigan License No. 28428

Date 12/14/99

A2052