

JAN 31 2001

LIBER 3121 PAGE 641
LAND CORNER RECORDATION CERTIFICATE
Filing Requirement of Act 74, Mich. P.A. 1970

STATE OF MICHIGAN
COUNTY OF MUSKEGON
RECEIVED FOR RECORD

200 DEC 20 PM 1:48

For corners in SECTION

Muskegon
(County)

Located In:

Corner Code #

1. Public Land Survey

T 9 N R 14 W

K-1 ✓

T R

T R

T 10 N R 14 W

K-13

2. Property Controlling in Section

S T R

S T R

3. Miscellaneous Property in Sec.

S T R

S T R

Mark Fairchild
REGISTER OF DEEDS

Register of Deeds Stamp & File Number

4. Lot No. , Recorded Plat

5. Private Claims

I, Stephen V. Vallier, in a field survey on November 14, 2000 do hereby state that under requirements of P.A. 74, Michigan P.A. of 1970, the corner points mentioned in lines 1 and 2 above were in conformance with regulations and rules therefore as required in the current manual of survey instructions of the United States Department of the Interior, Bureau of Land Management or by a decree of a Court of Law and/or that the corner points mentioned in lines 3, 4 and 5 above were in conformance with the rules of the Michigan Board of Land Surveyors or by a Decree of a Court of Law; established, re-established, monumented, recovered, found as expressed below:

NOTE: Not more than 2 corners, all in the same town and range, may be recorded on this certificate.

	A	B	C	D	E	F	G	H	I	J	K	L	M
1													
2	6		5		4		3		2		1		
3													
4	7		8		9		10		11		12		
5													
6	18		17		16		15		14		13		
7													
8	19		20		21		22		23		24		
9													
10	30		29		28		27		26		25		
11													
12	31		32		33		34		35		36		
13													

A. Description of original monument and accessories and/or subsequent restoration:

1837 John Mullett (G.L.O.) set post.
N 69° E 27 Links 6" Hemlock
N 03° W 16 Links 15" Beech

1968 Consumers Power Company found corner per Sheet 72, Drawing No. S-F 16758.

1982 Charles F. Lewandowski found a 1" pinched pipe, witnesses check with L.C.R.C. recorded in Liber 1242, Page 306. Reset corner with a 2 3/4 x 32" cast-iron monument with "County Surveyor Legend."

N 30° E 25.73' 12" Maple
S 35° E 18.5' 12" Oak
S 25° W 22.78' 22" Maple
N 75° W 17.13' 28" Oak

1994 Gerald T. Ford found a cast-iron monument recorded in Liber 1784, Page 566.

AZ 208° 22.65' Nail in S face of 28" Maple
AZ 826° 17.15' Nail in S Face of 31" Maple
AZ 152° 18.47' Nail in W face of 12" Maple
AZ 32° 25.72' Nail in E face of 12" Maple

POSITION OF SAID RECORDED CORNER REVIEWED & RATIFIED BY MUSKEGON COUNTY PEER GROUP IN ACCORDANCE WITH P.A. 345, OF 1990


B. Description of corner evidence found and/or method applied in restoring or reestablishing corner:

Found a 2 3/4" x 32" cast-iron monument with "County Surveyor Legend." Verified witnesses with LCRC, Liber 1242, Page 306. Old fence post at corner, no wire visible above ground. The position of the existing corner was accepted due to historical usage and documentation. No double corner or closing corner by G.L.O.

C. Description of monument for corner and accessories established to perpetuate locating the position of the corner:

A 2 3/4" x 32" cast-iron monument with a "County Surveyor Legend" was found.

N 30° E 25.73' Found spike E side of 12" Maple
N 83° E 39.40' Set spike N side of 8" Oak
S 55° E 21.77' Set spike NE side of Twin 4" x 8" Oak
S 35° E 18.50' Found spike SW side of 12" Oak
S 25° W 22.72' Found spike SE side of 28" Maple
N 75° W 17.13' Found spike S side of 32" Oak

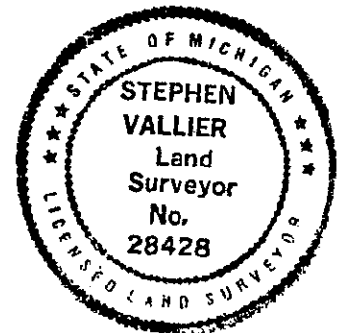

Signed by Stephen V. Vallier

Date 12/19/00

Surveyor's Michigan License No. 28428

A2109