

FEB 09 2000

LAND CORNER RECORDATION CERTIFICATE
Filing Requirement of Act 74, Mich. P.A. 1970

STATE OF MICHIGAN
COUNTY OF MUSKEGON
RECEIVED FOR RECORD
1999
DEC 27 PM 12: 46

For corners in SECTION

Muskegon (County)	Located In:	Corner Code #
1. Public Land Survey	T 9N R 14W	K-5
	T _____ R _____	_____
	T _____ R _____	_____
	T _____ R _____	_____
2. Property Controlling In Section	S _____ T _____ R _____	_____
	S _____ T _____ R _____	_____
3. Miscellaneous Property in Sec.	S _____ T _____ R _____	_____

Mark Fairchild
REGISTER OF DEEDS

Register of Deeds Stamp & File Number

4. Lot No. _____ Recorded Plat _____
5. Private Claims _____

I, Stephen V. Vallier, in a field survey on December 19, 1999, do hereby state that under requirements of P.A. 74, Michigan P.A. of 1970, the corner points mentioned in lines 1 and 2 above were in conformance with regulations and rules therefore as required in the current manual of survey instructions of the United States Department of the Interior, Bureau of Land Management or by a decree of a Court of Law and /or that the corner points mentioned in lines 3, 4 and 5 above were in conformance with the rules of the Michigan Board of Land Surveyors or by a Decree of a Court of Law; established, re-established, monumented, recovered, found as expressed below:

NOTE: Not more than 2 corners, all in the same town and range, may be recorded on this certificate.

	A	B	C	D	E	F	G	H	I	J	K	L	M
1													
2		6		5		4		3		2		1	
3													
4		7		8		9		10		11		12	
5													
6		18		17		16		15		14		13	
7													
8		19		20		21		22		23		24	
9													
10		30		29		28		27		26		25	
11													
12		31		32		33		34		35		36	
13													

MARK F. FAIRCHILD
MUSKEGON COUNTY
Register of Deeds
Recorded Copy!

A. Description of original monument and accessories and/or subsequent restoration:

- 1837 G.L.O. (John Mullett) set the quarter section post.
- 1950's MCRC's witness tie book notes an iron pipe.
East 48.8' Southwest corner of house
- 1984 C. F. Lewandowski found a 3/4" iron in monument box and reset with a 4"x30" cast-iron monument with a county surveyor's legend. Recorded L.C.R.C., in Liber 1301, Page 604.
N 55° E 35.18" Power Pole
East 48.87' Southwest corner of house
S 10° E 70.90' Center of northeasterly Bolt of R.R. signal base
S 55° W 22.00' Center northwesterly bolt of R.R. signal base
N 60° W 38.19' Power Pole


B. Description of corner evidence found and/or method applied in restoring or reestablishing corner:

- Found a 2 3/4" cast-iron monument in monument box with a county surveyor's cap. Corner is 33'± north of old R.R. grade.
N 55° E 35.18' Power Pole Found nail on north side
East 48.84' S/W corner of house

POSITION OF SAID
RECORDED CORNER
REVIEWED & RATIFIED
BY MUSKEGON COUNTY
REGISTER GROUP IN ACCORDANCE
WITH P.A. 645, OF 1990

C. Description of monument for corner and accessories established to perpetuate locating the position of the corner:

- Found a 2 3/4" cast-iron monument with a county surveyor's cap in monument box. Corner is 33'± north of an old R.R. grade.
N 20°W 90.25' Power Pole Set nail on east side
N 55°E 35.18' Power Pole Found nail on north side
East 48.84' S/W corner of house
West 30.60' "X" chiseled on the top of the curb at the south end

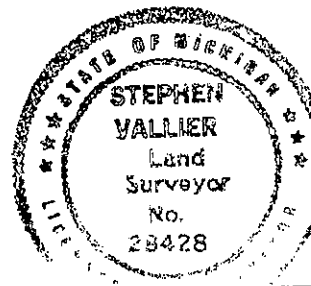

Signed by _____
Surveyor's Michigan License No. 28428

Date 12/22/99

A2081