

FEB 09 2000

LAND CORNER RECORDATION CERTIFICATE
Filing Requirement of Act 74, Mich. P.A. 1970

STATE OF MICHIGAN
COUNTY OF MUSKEGON
RECEIVED FOR RECORD

1999
DEC 27 PM 12: 45

For corners in SECTION

| Muskegon (County) | Located In: | Corner Code # |
|---------------------------------------|--------------------------|---------------|
| 1. Public Land Survey | T <u>9N</u> R <u>14W</u> | <u>K-7</u> |
| | T _____ R _____ | _____ |
| | T _____ R _____ | _____ |
| | T _____ R _____ | _____ |
| 2. Property Controlling In Section | S _____ T _____ R _____ | _____ |
| | S _____ T _____ R _____ | _____ |
| 3. Miscellaneous Property in Sec. | S _____ T _____ R _____ | _____ |
| | S _____ T _____ R _____ | _____ |
| 4. Lot No. _____, Recorded Plat _____ | | |
| 5. Private Claims _____ | | |

Mark Fairchild
REGISTER OF DEEDS

Register of Deeds Stamp & File Number

I, Stephen V. Vallier, in a field survey on December, 1999, do hereby state that under requirements of P.A. 74, Michigan P.A. of 1970, the corner points mentioned in lines 1 and 2 above were in conformance with regulations and rules therefore as required in the current manual of survey instructions of the United States Department of the Interior, Bureau of Land Management or by a decree of a Court of Law and /or that the corner points mentioned in lines 3, 4 and 5 above were in conformance with the rules of the Michigan Board of Land Surveyors or by a Decree of a Court of Law; established, re-established, monumented, recovered, found as expressed below:

NOTE: Not more than 2 corners, all in the same town and range, may be recorded on this certificate.

| | A | B | C | D | E | F | G | H | I | J | K | L | M |
|----|----|---|----|---|----|---|----|---|----|---|----|---|---|
| 1 | | | | | | | | | | | | | |
| 2 | 6 | | 5 | | 4 | | 3 | | 2 | | 1 | | |
| 3 | | | | | | | | | | | | | |
| 4 | 7 | | 8 | | 9 | | 10 | | 11 | | 12 | | |
| 5 | | | | | | | | | | | | | |
| 6 | 18 | | 17 | | 16 | | 15 | | 14 | | 13 | | |
| 7 | | | | | | | | | | | | | |
| 8 | 19 | | 20 | | 21 | | 22 | | 23 | | 24 | | |
| 9 | | | | | | | | | | | | | |
| 10 | 30 | | 29 | | 28 | | 27 | | 26 | | 25 | | |
| 11 | | | | | | | | | | | | | |
| 12 | 31 | | 32 | | 33 | | 34 | | 35 | | 36 | | |
| 13 | | | | | | | | | | | | | |

A. Description of original monument and accessories and/or subsequent restoration:

1837 G.L.O. (John Mullett) set the quarter section posts for Sections 13, 14, 23, and 24.
N 35° W 2 Links 60" Lynn
S 05° W 4 Links 6" Beech

1950's M.C.R.C.'s witness tie book notes an iron pipe.
SE 79.2' 16" Maple
SE 67.7' 18" Maple

1984 C. F. Lewandowski found a 1/2" iron pipe in a monument box, and reset with a 4" x 30" cast-iron monument with a county surveyor's legend. Recorded L.C.R.C. in Liber 1301, Page 608.
N 60° E 73.82' Power Pole
S 65° E 67.68' 18" Maple
S 20° E 29.23' 16" Maple
S 60° W 46.93' 6" Pole

MARK F. FAIRCHILD
MUSKEGON COUNTY
Register of Deeds
Recorded Copy!

B. Description of corner evidence found and/or method applied in restoring or reestablishing corner:

Found a 4" cast-iron monument with county surveyor's cap in the center line of the road intersection in a monument box. Accepted the position of corner due to historical usage and documentation. Evidence that the corner is a correct and true perpetuation of the G.L.O. corner is inconclusive.


N 60° E 72.60" Power Pole Set nail on southeast side

POSITION OF SAID SW
RECORDED CORNER 8/10/99
REVIEWED & RATIFIED
BY MUSKEGON COUNTY
PEER GROUP IN ACCORDANCE
WITH P.A. 345, OF 1990

C. Description of monument for corner and accessories established to perpetuate locating the position of the corner:

Found a 4" cast-iron monument with a county surveyor's cap in the C/L of the road intersection in a monument box.

N 60° E 72.60' Power Pole Set nail on southeast side
S 75° E 99.20' 28" Maple
S 20° E 120.70' 16" Maple
S 60° W 77.00' 6" Pole Found nail on south side

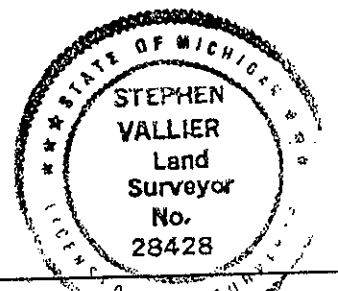

Signed by [Signature]
Surveyor's Michigan License No. 28428

Date 12/22/99

A2075