

**FEB 09 2000**

**STATE OF MICHIGAN  
LAND CORNER RECORDATION CERTIFICATE COUNTY OF MUSKEGON  
Filing Requirement of Act 74, Mich. P.A. 1970**

**1999 DEC 27 PM 12:46**

*Mark Fairchild*  
**REGISTER OF DEEDS**

**Register of Deeds Stamp & File Number**

For corners in

**SECTION**

Muskegon (County)	Located In:	Corner Code #
1. Public Land Survey	T <u>9N</u> R <u>14W</u>	<u>K-8</u>
	T _____ R _____	_____
	T _____ R _____	_____
	T _____ R _____	_____
2. Property Controlling In Section	S _____ T _____ R _____	_____
	S _____ T _____ R _____	_____
3. Miscellaneous Property in Sec.	S _____ T _____ R _____	_____
	S _____ T _____ R _____	_____
4. Lot No. _____, Recorded Plat _____		
5. Private Claims _____		

I, Stephen V. Vallier, in a field survey on December, 1999, do hereby state that under requirements of P.A. 74, Michigan P.A. of 1970, the corner points mentioned in lines 1 and 2 above were in conformance with regulations and rules therefore as required in the current manual of survey instructions of the United States Department of the Interior, Bureau of Land Management or by a decree of a Court of Law and /or that the corner points mentioned in lines 3, 4 and 5 above were in conformance with the rules of the Michigan Board of Land Surveyors or by a Decree of a Court of Law; established, re-established, monumented, recovered, found as expressed below:

**NOTE: Not more than 2 corners, all in the same town and range, may be recorded on this certificate.**

A	B	C	D	E	F	G	H	I	J	K	L	M
2	6	5	4	3	2	1						
3												
4	7	8	9	10	11	12						
5												
6	13	17	16	15	14	13						
7												
8	19	20	21	22	23	24						
9												
10	30	29	28	27	26	25						
11												
12	31	32	33	34	35	36						
13												

**A. Description of original monument and accessories and/or subsequent restoration:**

1837 G.L.O. (John Mullett) set the quarter section post.  
12" Sugar for Corner

1929 M.C.R.C. found a stone and stake.  
East 28.65' Fence Post  
NE 28.55' Telephone Pole  
West 28.35' Fence Post

1984 C. F. Lewandowski found a 1 1/2" pipe in monument box, and reset with a 4" x30" cast-iron monument in monument box.  
S 85° E 52.35' 8" Elm  
S 25° E 100.10' Telephone Pole  
S 25° W 101.92' Power Pole  
West 31.29' Fence Post

**MARK F. FAIRCHILD**  
**MUSKEGON COUNTY**  
Register of Deeds  
Recorded Copy!

POSITION OF SAID  
RECORDED CORNER *SW*  
REVIEWED & RATIFIED *8/10/99*  
BY MUSKEGON COUNTY  
PEER GROUP IN ACCORDANCE  
WITH P.A. 345, OF 1970


**B. Description of corner evidence found and/or method applied in restoring or reestablishing corner:**

Found a 4" cast-iron monument with a county surveyor's cap in monument box on the occupation line to the east. Accepted the position of corner due to historical usage and documentation. Evidence is inconclusive of corner position being a perpetuation of the original G.L.O. come  
S 25° W 101.92' Power Pole

**C. Description of monument for corner and accessories established to perpetuate locating the position of the corner:**

Found a cast-iron monument with a county surveyor's cap in monument box.  
S 25° W 101.92' Power Pole Found nail on north side  
S 85° E 59.00' 12" Elm  
West 38.70' Fence Post

North 2639.36' to Corner K-7.  
South 2651.34' to Corner K-9.

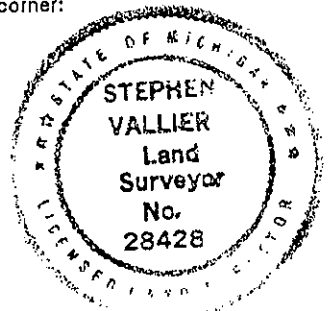

Signed by *Stephen Vallier*  
Surveyor's Michigan License No. 28428

Date 12/22/99

*A 2080*