

FEB 09 2000

LIBER 2326 PAGE 787
LAND CORNER RECORDATION CERTIFICATE
 Filing Requirement of Act 74, Mich. P.A. 1970

STATE OF MICHIGAN
 COUNTY OF MUSKEGON
 RECEIVED FOR RECORD

1999 DEC 27 PM 12:45

For corners in **SECTION**

<u>Muskegon</u> (County)	Located In:	Corner Code #
1. Public Land Survey	T <u>9N</u> R <u>14W</u>	<u>L-5</u>
	T _____ R _____	_____
	T _____ R _____	_____
	T _____ R _____	_____
2. Property Controlling In Section	S _____ T _____ R _____	_____
	S _____ T _____ R _____	_____
3. Miscellaneous Property in Sec.	S _____ T _____ R _____	_____
	S _____ T _____ R _____	_____
4. Lot No. _____, Recorded Plat _____		
5. Private Claims _____		

Mark Fairchild
 REGISTER OF DEEDS

Register of Deeds Stamp & File Number

I, Stephen V. Vallier, in a field survey on December, 1999, do hereby state that under requirements of P.A. 74, Michigan P.A. of 1970, the corner points mentioned in lines 1 and 2 above were in conformance with regulations and rules therefore as required in the current manual of survey instructions of the United States Department of the Interior, Bureau of Land Management or by a decree of a Court of Law and /or that the corner points mentioned in lines 3, 4 and 5 above were in conformance with the rules of the Michigan Board of Land Surveyors or by a Decree of a Court of Law; established, re-established, monumented, recovered, found as expressed below:

NOTE: Not more than 2 corners, all in the same town and range, may be recorded on this certificate.

	A	B	C	D	E	F	G	H	I	J	K	L	M
1													
2	6		5		4		3		2		1		
3													
4	7		8		9		10		11		12		
5													
6	18		17		16		15		14		13		
7													
8	19		20		21		22		23		24		
9													
10	30		29		28		27		26		25		
11													
12	31		32		33		34		35		36		
13													

A. Description of original monument and accessories and/or subsequent restoration:

1837 G.L.O. (John Mullett) set the quarter section post.
 S 72° E 54 Links 24" Elm
 N 71° W 5 Links 8" Elm

1967 W. Works of Consumer Power Company set an iron on the east side of a large fence post on the north-south fence and a tree line to the east.

1977 C. Englert set 1/2" rod on occupation north, south, and to the east. Recorded L.C.R.C. in Liber 1118, Page 937.
 WNW 17.09' 7" Basswood
 NW 25.15' 5" Basswood
 N 5.30' 5" Basswood

1984 C.F. Lewandowski found a capped iron, and reset with a 4"x30" cast-iron monument with a County Surveyor's Cap. Recorded L.C.R.C. in Liber 1301, Page 607.
 N 20° W 6.05' 6" Basswood Clump
 N 55° W 19.75' 6" Elm

MARK F. FAIRCHILD
MUSKEGON COUNTY
 Register of Deeds
 Recorded Copy!

POSITION OF SAID SW
 RECORDED CORNER 8/10/99
 REVIEWED & RATIFIED
 BY MUSKEGON COUNTY
 PEER GROUP IN ACCORDANCE
 WITH P.A. 345, OF 1990

B. Description of corner evidence found and/or method applied in restoring or reestablishing corner:

Found a 4" cast-iron monument with a county surveyor's cap flush with ground in a rock pile. The corner is on the north/south fence line and occupation line to the west. No evidence of the 1967 Consumer Power Company's corner, although, large fence post is lying down approximately 4' south of the found monument. Accepted the position of found monument due to the historical usage and documentation. Evidence is inconclusive that the corner is a true and correct perpetuation of the G.L.O. corner.


N 20° W 6.05' 8" Basswood Clump
 N 55° W 19.75' 12" Dead Elm
 N 20° W 25.10' 8" Basswood Cluster

C. Description of monument for corner and accessories established to perpetuate locating the position of the corner:

Found a 4" cast-iron monument with a county surveyor's cap. Monument is flush with the ground in a rock pile on the north/south fence line.
 N 20° W 6.05' 8" Basswood Clump Set nail on east side
 N 55° W 19.75' 12" Dead Elm
 N 20° W 25.10' 8" Basswood Cluster
 N 50° W 22.00' Top of 2' Stone
 South 9.00' 6" Maple

Signed by Stephen V. Vallier
 Surveyor's Michigan License No. 28428

Date 12/22/99

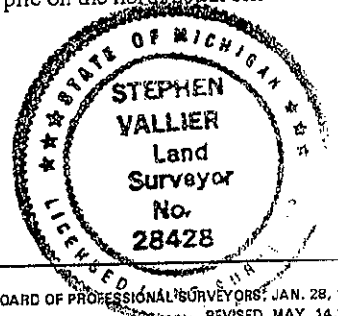

A2076