

FEB 09 2000

LAND CORNER RECORDATION CERTIFICATE
Filing Requirement of Act 74, Mich. P.A. 1970

STATE OF MICHIGAN
COUNTY OF MUSKEGON
RECEIVED FOR RECORD

1999
DEC 27 PM 12:45

For corners in

SECTION

Muskegon (County)	Located In:	Corner Code #
1. Public Land Survey	T <u>9N</u> R <u>14W</u>	<u>L-9</u>
	T _____ R _____	_____
	T _____ R _____	_____
	T _____ R _____	_____
2. Property Controlling In Section	S _____ T _____ R _____	_____
	S _____ T _____ R _____	_____
3. Miscellaneous Property in Sec.	S _____ T _____ R _____	_____
	S _____ T _____ R _____	_____

Mark Fairchild
REGISTER OF DEEDS

Register of Deeds Stamp & File Number

- 4. Lot No. _____, Recorded Plat _____
- 5. Private Claims _____

I, Stephen V. Vallier, in a field survey on December, 1999, do hereby state that under requirements of P.A. 74, Michigan P.A. of 1970, the corner points mentioned in lines 1 and 2 above were in conformance with regulations and rules therefore as required in the current manual of survey instructions of the United States Department of the Interior, Bureau of Land Management or by a decree of a Court of Law and /or that the corner points mentioned in lines 3, 4 and 5 above were in conformance with the rules of the Michigan Board of Land Surveyors or by a Decree of a Court of Law; established, re-established, monumented, recovered, found as expressed below:

NOTE: Not more than 2 corners, all in the same town and range, may be recorded on this certificate.

	A	B	C	D	E	F	G	H	I	J	K	L	M
1													
2	6	5	4	3	2	1							
3													
4	7	8	9	10	11	12							
5													
6	10	17	16	15	14	13							
7													
8	19	20	21	22	23	24							
9													
10	30	29	28	27	26	25							
11													
12	31	32	33	34	35	36							
13													

MARK F. FAIRCHILD
MUSKEGON COUNTY
Register of Deeds
Recorded Copy!

A. Description of original monument and accessories and/or subsequent restoration:

- 1837 G.L.O. (John Mullett) set the quarter section post.
N 6° W 20 Links 12" Beech
S 68° E 12 Links 8" Beech
E 2.16 Chains Stream 10 Links wide, course south
- 1972 C. Englert found a 10"x10"x15" pointed stone, and set 1/2" iron rod under the stone, as recorded in L.C.R.C. in Liber 988, Page 136.
NW 1.60' Fence Post
NE 1.25' Fence Post
w 53.11' 6" Ash
- 1984 C.F. Lewandowski found a stone on top of a 1/2" rod. Reset with a 4"x30" cast-iron monument with a County Surveyor's Legend.
W 53.11' 12" Ash
N 30° E 27.20' 6" Thorn Apple
S 25° E 21.26' 4" Cherry
E 37.64' 6" Cherry

POSITION OF SAID
RECORDED CORNER 8/10/99
REVIEWED & RATIFIED
BY MUSKEGON COUNTY
PEER GROUP IN ACCORDANCE
WITH P.A. 345, OF 1900

B. Description of corner evidence found and/or method applied in restoring or reestablishing corner:


Found a 4" cast-iron monument on the east/west and north/south fence intersection. Monument is flush with the ground. No evidence of stone found. Corner is within 2' of single- proportionate measure for mile. Accepted the position of corner due to historical usage and documentation. The G.L.O. distance to the creek is 142.65' (2.16 Chains); the present measure is 100' to the high point of oxbow of creek bed.

West	53.11'	12" Ash Stump
N 30° E	27.20'	9" Thorn Apple
S 25° E	21.26'	9" Cherry
East	37.64'	12" Cherry

C. Description of monument for corner and accessories established to perpetuate locating the position of the corner:

Found a 4" cast-iron monument with a county surveyor's cap at the intersection of the north/south and east/west fence line.

West	53.11'	12" Ash Stump	
N 30° E	27.20'	9" Thorn Apple	
S 25° E	21.26'	9" Cherry	Found nail on west side
East	37.64'	12" Cherry	Found nail on north side
West	13.50'	10" Twin Cherry	Set nail on north side
North	1.25'	Fence Post	
N.W.	1.60'	Fence Post	

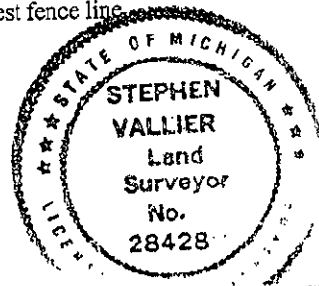

Signed by Stephen V. Vallier
Surveyor's Michigan License No. 28428

Date 12/22/99
FORM APPROVED BY MICHIGAN STATE BOARD OF PROFESSIONAL SURVEYORS, JAN. 28, REVISED MAY 14, REVISED JAN., REVISED OCT.,

A2072