

FEB 09 2000

LAND CORNER RECORDATION CERTIFICATE
Filing Requirement of Act 74, Mich. P.A. 1970

STATE OF MICHIGAN
COUNTY OF MUSKEGON
RECEIVED FOR RECORD

1999
DEC 27 PM 12:45

For corners in SECTION

<u>Muskegon</u> (County)	Located In:	Corner Code #
1. Public Land Survey	T <u>9N</u> R <u>14W</u>	<u>L-11</u>
	T _____ R _____	_____
	T _____ R _____	_____
	T _____ R _____	_____
2. Property Controlling In Section	S _____ T _____ R _____	_____
	S _____ T _____ R _____	_____
3. Miscellaneous Property in Sec.	S _____ T _____ R _____	_____
	S _____ T _____ R _____	_____
4. Lot No. _____, Recorded Plat _____		
5. Private Claims _____		

Mark Fairchild
REGISTER OF DEEDS

Register of Deeds Stamp & File Number

I, Stephen V. Vallier, in a field survey on December, 1999, do hereby state that under requirements of P.A. 74, Michigan P.A. of 1970, the corner points mentioned in lines 1 and 2 above were in conformance with regulations and rules therefore as required in the current manual of survey instructions of the United States Department of the Interior, Bureau of Land Management or by a decree of a Court of Law and /or that the corner points mentioned in lines 3, 4 and 5 above were in conformance with the rules of the Michigan Board of Land Surveyors or by a Decree of a Court of Law; established, re-established, monumented, recovered, found as expressed below:

NOTE: Not more than 2 corners, all in the same town and range, may be recorded on this certificate.

A	B	C	D	E	F	G	H	I	J	K	L	M
1												
2	6	5	4	3	2	1						
3												
4	7	8	9	10	11	12						
5												
6	18	17	16	15	14	13						
7												
8	19	20	21	22	23	24						
9												
10	30	29	28	27	26	25						
11												
12	31	32	33	34	35	36						
13												

A. Description of original monument and accessories and/or subsequent restoration:

- 1837 G.L.O. (John Mullett) set the quarter section post.
S 49° E 13 Links 24" Sugar
N 46° E 14 Links 8" Sugar
East 5.28 Chains Stream - 15 Links wide
- 1982 C. F. Lewandowski found a 1/2" iron rod and reset with a 4" x 30" cast-iron monument with County Surveyor's Legend in the gravel road. Recorded L.C.R.C. in Liber 1242, Page 324.
S 65° E 264.08' Power Pole
S 15° W 108.50' Power Pole
N 18° E 22.70' C/L St. Sign

MARK F. FAIRCHILD
MUSKEGON COUNTY
Register of Deeds
Recorded Copy!

B. Description of corner evidence found and/or method applied in restoring or reestablishing corner:


Found a broken 4" cast-iron monument in the center line of gravel road on the occupation line to the north. Monument is approximately 1' deep. Accepted the position of corner due to historical usage and documentation. Evidence is inconclusive that the corner is a correct perpetuation of the G.L.O. corner.

- S 65° E 264.08' Power Pole Found nail on north side
- S 15° W 108.50' Power Pole Found nail on West side
- N 18° E 22.70' Center of St. Sign

POSITION OF SAID *SW*
RECORDED CORNER *9/14/99*
REVIEWED & RATIFIED
BY MUSKEGON COUNTY
PEER GROUP IN ACCORDANCE
WITH P.A. 345, OF 1990

C. Description of monument for corner and accessories established to perpetuate locating the position of the corner:

- Found a broken 4" cast-iron monument in the center line of gravel road.
S 65° E 264.08' Power Pole Found nail on north side
S 15° W 108.50' Power Pole Found nail on West side
N 18° E 22.70' Center of St. Sign

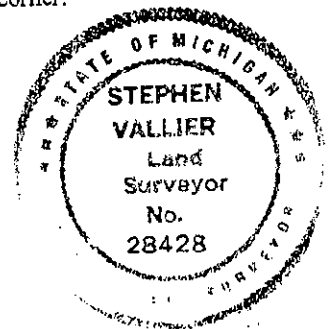

Signed by *Stephen Vallier*
Surveyor's Michigan License No. 28428

Date 12/27/99
FORM APPROVED BY MICHIGAN STATE BOARD OF PROFESSIONAL SURVEYORS, JAN. 28, REVISED MAY 14, REVISED JAN., REVISED OCT.

A2071