

FEB 09 2000

LAND CORNER RECORDATION CERTIFICATE
Filing Requirement of Act 74, Mich. P.A. 1970

STATE OF MICHIGAN
COUNTY OF MUSKEGON
RECEIVED FOR RECORD

For corners in

SECTION

Muskegon (County)	Located In:	Corner Code #
1. Public Land Survey	T <u>9N</u> R <u>14W</u>	<u>M-6</u>
	T _____ R _____	_____
	T _____ R _____	_____
	T _____ R _____	_____
2. Property Controlling In Section	S _____ T _____	_____
	S _____ T _____	_____
3. Miscellaneous Property in Sec.	S _____ T _____	_____
	S _____ T _____	_____
4. Lot No. _____, Recorded Plat _____		
5. Private Claims _____		

1999 DEC 27 PM 12: 45

Mark F Fairchild
REGISTER OF DEEDS

Register of Deeds Stamp & File Number

I, Stephen V. Vallier, in a field survey on November, 1999, do hereby state that under requirements of P.A. 74, Michigan P.A. of 1970, the corner points mentioned in lines 1 and 2 above were in conformance with regulations and rules therefore as required in the current manual of survey instructions of the United States Department of the Interior, Bureau of Land Management or by a decree of a Court of Law and /or that the corner points mentioned in lines 3, 4 and 5 above were in conformance with the rules of the Michigan Board of Land Surveyors or by a Decree of a Court of Law; established, re-established, monumented, recovered, found as expressed below:

NOTE: Not more than 2 corners, all in the same town and range, may be recorded on this certificate.

	A	B	C	D	E	F	G	H	I	J	K	L	M
1													
2	6		5		4		3		2		1		
3													
4	7		8		9		10		11		12		
5													
6	18		17		16		15		14		13		
7													
8	19		20		21		22		23		24		
9													
10	30		29		28		27		26		25		
11													
12	31		32		33		34		35		36		
13													

A. Description of original monument and accessories and/or subsequent restoration:

1837 G.L.O. (John Mullett) set quarter section post.
S 88° W 18 Links 22" Beech
N 44° W 42 Links 18" Sugar Maple

1977 C. Englert found a 3/4" iron pipe, as recorded in L.C.R.C., Liber 1118, Page 934.
NE 26.01' 30" Maple
NNE 45.84' 24" Maple
NW 42.80' 30" Maple
SE 34.70' 36" Maple
SW 38.80' 4" Maple

1981 Ottawa County Surveyor, T. Joiner, found an iron, and reset a 4"x30" cast-iron monument, as recorded in L.C.R.C., Liber 4, Page 236 of Ottawa County Records.

1984 Found a 4" cast-iron monument, as recorded in Liber 1118, Page 934. Witness check as follows:
N 35° E 45.77' 18" Maple
S 45° E 34.75' 44" Maple
S 40° W 38.80' 6" Maple
N 35° W 42.75' 22" Maple

MARK F. FAIRCHILD
MUSKEGON COUNTY
Register of Deeds
Recorded Copy!

POSITION OF SAID *SW*
RECORDED CORNER *8/10/99*
REVIEWED & RATIFIED
BY MUSKEGON COUNTY
PEER GROUP IN ACCORDANCE
WITH P.A. 345, OF 1990

B. Description of corner evidence found and/or method applied in restoring or reestablishing corner:


Found a 4" cast-iron monument with a County Surveyor's Cap on the east and west fence line. Accepted position of the 4" cast-iron monument due to historical usage and documentation. Evidence that corner is the correct perpetuation of the G.L.O. corner is inconclusive.
N 35° E 45.77' 18" Maple Found nail on southwest side
S 45° E 34.75' 44" Maple Found nail on southwest side
N 35° W 42.75' 22" Maple Found nail on east side

C. Description of monument for corner and accessories established to perpetuate locating the position of the corner:

Found a 4" cast-iron monument with County Surveyor's Cap approximately 1' deep in gravel road.
N 35° E 45.77' 18" Maple Found nail on southwest side
S 45° E 34.75' 44" Maple Found nail on southwest side
N 35° W 42.75' 22" Maple Found nail on east side

Signed by *Stephen V. Vallier*
Surveyor's Michigan License No. 28428

Date 12/27/99

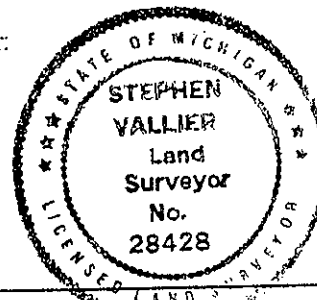

A2070