

**SURVEY & REMONUMENTATION**

**FEB 09 2000**

**LIBER 2326 PAGE 794**  
**STATE OF MICHIGAN**  
**LAND CORNER RECORDATION CERTIFICATE**  
**Filing Requirement of Act 74, Mich. P.A. 1970**

**COUNTY OF MUSKEGON**  
**RECEIVED FOR RECORD**



1999 DEC 27 PM 12:46

*Mark Fairchild*  
**REGISTER OF DEEDS**

Register of Deeds Stamp & File Number

For corners in **SECTION**

Muskegon Located In: Corner Code #  
 (County)

1. Public Land Survey T 9N R 14W M-7  
 T \_\_\_\_\_ R \_\_\_\_\_  
 T \_\_\_\_\_ R \_\_\_\_\_  
 T \_\_\_\_\_ R \_\_\_\_\_

2. Property Controlling S \_\_\_\_\_ T \_\_\_\_\_ R \_\_\_\_\_  
 In Section S \_\_\_\_\_ T \_\_\_\_\_ R \_\_\_\_\_

3. Miscellaneous S \_\_\_\_\_ T \_\_\_\_\_ R \_\_\_\_\_  
 Property in Sec. S \_\_\_\_\_ T \_\_\_\_\_ R \_\_\_\_\_

4. Lot No. \_\_\_\_\_, Recorded Plat \_\_\_\_\_

5. Private Claims \_\_\_\_\_

I, Stephen V. Vallier, in a field survey on December, 1999, do hereby state that under requirements of P.A. 74, Michigan P.A. of 1970, the corner points mentioned in lines 1 and 2 above were in conformance with regulations and rules therefore as required in the current manual of survey instructions of the United States Department of the Interior, Bureau of Land Management or by a decree of a Court of Law and /or that the corner points mentioned in lines 3, 4 and 5 above were in conformance with the rules of the Michigan Board of Land Surveyors or by a Decree of a Court of Law; established, re-established, monumented, recovered, found as expressed below:

NOTE: Not more than 2 corners, all in the same town and range, may be recorded on this certificate.

A	B	C	D	E	F	G	H	I	J	K	L	M
1												
2	6	5	4	3	2	1						
3												
4	7	8	9	10	11	12						
5												
6	18	17	16	15	14	13						
7												
8	19	20	21	22	23	24						
9												
10	30	29	28	27	26	25						
11												
12	31	32	33	34	35	36						
13												


A. Description of original monument and accessories and/or subsequent restoration:

1837 G.L.O. (John Mullett) set corner posts to Sections 13 and 24.

1977 C. Englert found 3/4" iron rod in monument box.  
 NW 45.79' Fence Post  
 NE 86.52' Power Pole  
 SE 43.35' Street Sign  
 SW 52.50' Street Sign

1982 Ottawa County Surveyor, T. Joiner, set a 2 3/4" cast-iron monument in monument box. Recorded L.C.R.C. in Liber 5, Page 8, Ottawa County Records.

1984 C.F. Lewandowski found a broken 2 3/4" cast-iron monument in monument box. Recorded L.C.R.C. in Liber 1301, Page 603.  
 N 45° E 86.55' Power Pole  
 S 45° E 43.55' Cut in Sign Post Base  
 N 25° W 86.46' 40" Maple

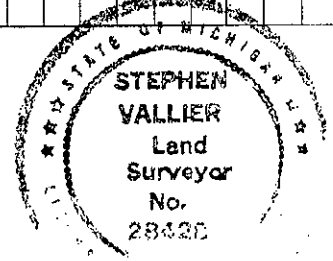

POSITION OF SAID RECORDED CORNER *SW*  
 REVIEWED & RATIFIED *8/10/99*  
 BY MUSKEGON COUNTY PEER GROUP IN ACCORDANCE WITH P.A. 345, OF 1990

B. Description of corner evidence found and/or method applied in restoring or reestablishing corner:

Found broken 2 3/4" cast-iron monument in monument box. Accepted the position of corner due to historical usage and documentation. Evidence of perpetuation of the original G.L.O. corner is non-supportive.  
 N 45° E 86.55' Power Pole Found nail on north side  
 N 25° W 86.46' 40" Maple Found nail on east side

C. Description of monument for corner and accessories established to perpetuate locating the position of the corner:

Found broken 2 3/4" cast-iron monument in a monument box at the center line of Squires and Ellis Roads.  
 S 45° E 43.35' "X" cut in concrete base of road sign  
 S 45° W 59.00' C/L of Telephone Riser  
 W 177.00' C/L of old R.R. Crossing  
 S 264.00' C/L of old R.R. Crossing  
 N 45° E 86.55' Power Pole Found nail on north side  
 N 25° W 86.46' 40" Maple Found nail on east side

**MARK F. FAIRCHILD**  
**MUSKEGON COUNTY**  
**Register of Deeds**  
**Recorded Copy!**

Signed by: *Stephen V. Vallier*  
 Surveyor's Michigan License No. 28420

Date 12/22/99

*A2083*