

FEB 09 2000

LIBER 2326 PAGE 777

STATE OF MICHIGAN  
LAND CORNER RECORDATION CERTIFICATE COUNTY OF MUSKEGON  
Filing Requirement of Act 74, Mich. P.A. 1970 RECEIVED FOR RECORD

1999 DEC 27 PM 12:44

For corners in SECTION

Muskegon (County)	Located In:	Corner Code #
1. Public Land Survey	T <u>9N</u> R <u>14W</u>	<u>M-11</u>
	T _____ R _____	_____
	T _____ R _____	_____
	T _____ R _____	_____
2. Property Controlling In Section	S _____ T _____ R _____	_____
	S _____ T _____ R _____	_____
3. Miscellaneous Property in Sec.	S _____ T _____ R _____	_____

*Mark F. Fairchild*  
REGISTER OF DEEDS

Register of Deeds Stamp & File Number

4. Lot No. \_\_\_\_\_, Recorded Plat \_\_\_\_\_  
5. Private Claims \_\_\_\_\_

I, Stephen V. Vallier, in a field survey on December, 1999, do hereby state that under requirements of P.A. 74, Michigan P.A. of 1970, the corner points mentioned in lines 1 and 2 above were in conformance with regulations and rules therefore as required in the current manual of survey instructions of the United States Department of the Interior, Bureau of Land Management or by a decree of a Court of Law and /or that the corner points mentioned in lines 3, 4 and 5 above were in conformance with the rules of the Michigan Board of Land Surveyors or by a Decree of a Court of Law; established, re-established, monumented, recovered, found as expressed below:

NOTE: Not more than 2 corners, all in the same town and range, may be recorded on this certificate.

	A	B	C	D	E	F	G	H	I	J	K	L
1												
2	6	5	4	3	2							
3												
4	7	8	9	10	11	12						
5												
6	18	17	16	15	14	13						
7												
8	19	20	21	22	23	24						
9												
10	30	29	28	27	26	25						
11												
12	31	32	33	34	35	36						
13												

A. Description of original monument and accessories and/or subsequent restoration:

1837 G.L.O. (John Mullett) set the corner posts to Sections 25 and 36.  
S 4° W 27 Links 9" Beech  
N 85° W 13 Links 8" Beech

1981 Ottawa County Surveyor (T. Joiner) found a 1" pipe, and reset a 4" x 30" cast-iron monument, as recorded in L.C.R.C., Liber 4, Page 222 of the Ottawa County Records.

1984 C.F. Lewandowski found a 4" cast-iron monument with a Section Corner Legend.  
N 70° E 82.12' Power Pole  
N 21° W 76.90' 16" Apple  
N 64° W 79.55' 12" Apple  
S 25° E 124.00' Power Pole

POSITION OF SAID  
RECORDED CORNER  
REVIEWED & RATIFIED  
BY MUSKEGON COUNTY  
PEER GROUP IN ACCORDANCE  
WITH P.A. 345, OF 1990  
*sw 9/14/99*

B. Description of corner evidence found and/or method applied in restoring or reestablishing corner:


Found a 4" cast-iron monument in the center line of roads approximately 1' deep. Accepted the corner position due to historical usage and documentation. Evidence of corner position being a perpetuation of the original G.L.O. position is non-supportive.

N 70° E 82.12' Power Pole Found nail on south side  
N 21° W 76.90' 16" Apple Stump  
N 64° W 79.55' 12" Apple Found nail on south side  
S 35° E 124.50' Power Pole Found nail on west side

**MARK F. FAIRCHILD**  
MUSKEGON COUNTY  
Register of Deeds  
Recorded Copy!

C. Description of monument for corner and accessories established to perpetuate locating the position of the corner:

Found a 4" cast-iron monument with a County Surveyor's Cap.  
N 70° E 82.12' Power Pole Found nail on south side  
N 21° W 76.90' 16" Apple Stump  
N 64° W 79.55' 12" Apple Found nail on south side  
S 35° E 124.50' Power Pole Found nail on west side

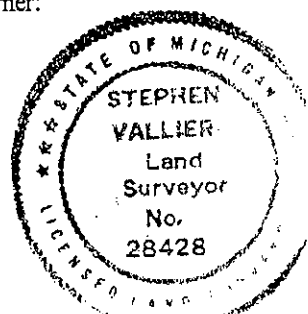

Signed by *Stephen Vallier*  
Surveyor's Michigan License No. 28428

Date 12/22/99