

**SURVEY &  
REMONUMENTATION**

LIBER **1810** PAGE **600**

APR 28 1995

**LAND CORNER RECORDATION CERTIFICATE**  
Filing Requirement of Act 74, Mich. P.A. 1970

STATE OF MICHIGAN  
COUNTY OF MUSKEGON  
RECEIVED FOR RECORD

1994 DEC 29 AM 10:16

**COMMISSION**

For corners in

*Carrie Carter*  
REGISTER OF DEEDS

	Located In:	Corner Code #
_____ Muskegon _____		
1. Public Land Survey	T <u>9</u> R <u>15</u>	<u>B-1</u>
	T _____ R _____	_____
	T _____ R _____	_____
	T _____ R _____	_____
2. Property Controlling in Section	S _____ T _____ R _____	_____
	S _____ T _____ R _____	_____
3. Miscellaneous Property in Sec.	S _____ T _____ R _____	_____
	S _____ T _____ R _____	_____

*A1624*

Register of Deeds Stamp & File Number

4. Lot No. \_\_\_\_\_, Recorded Plat \_\_\_\_\_  
5. Private Claims \_\_\_\_\_

	A	B	C	D	E	F	G	H	I	J	K	L	M
2	6	5	4	3	2	1							
3													
4	7	8	9	10	11	12							
5													
6	18	17	16	15	14	13							
7													
8	19	20	21	22	23	24							
9													
10	30	29	28	27	26	25							
11													
12	31	32	33	34	35	36							
13													

I, Stephen V. Vallier field survey on November, 19 94, do hereby certify that under requirements of P.A. 74, Michigan P.A. of 1970, the corner points mentioned in lines 1 and 2 above were in conformance with regulations and rules therefore as required in the current manual of survey instructions of the United States Department of the Interior, Bureau of Land Management or by a decree of a Court of Law and/or that the corner points mentioned in lines 3, 4 and 5 above were in conformance with the rules of the Michigan Board of Land Surveyors or by a Decree of a Court of Law; established, re-established, monumented, re-monumented, recovered, found as expressed below:

**NOTE: Not more than 4 corners, all in the same town and range, may be recorded on this certificate.**

A. Description of original monument and accessories and/or subsequent restoration:

1837 GLO set corner  
1984 C.F. Lewandowski - L.C.R.C. Liber 1290 Page 977 - set as last corner by single proportionate measure. Placed 4" x 30" cast iron monument with County Survey Cap at corner.

B. Description of corner evidence found and/or method applied in restoring or reestablishing corner:

Found 4" cast iron monument with County Survey Cap.  
Accepted position of corner due to evidence of Historical usage and consistent documentation.


POSITION OF SAID  
RECORDED CORNER  
REVIEWED & RATIFIED  
BY MUSKEGON COUNTY  
PEER GROUP IN ACCORDANCE  
WITH P.A. 845, OF 1990

*Sept 7, 1995*

C. Description of monument for corner and accessories established to perpetuate locating the position of the corner:

4" Cast Iron Monument with County survey Cap.

S 86 deg E 23.33' 14" Twin Oak with nail  
N 44 deg E 17.89' 10" Beech with nail  
E 9.90' County Monument (S 1/4 Post Section 31, T10N, R15W)  
N 35 deg E 9.92' 8" Maple with nail  
N 40 deg W 27.39' 16" Maple with nail  
S 45 deg E 41.52' 14" Dead Hemlock with nail

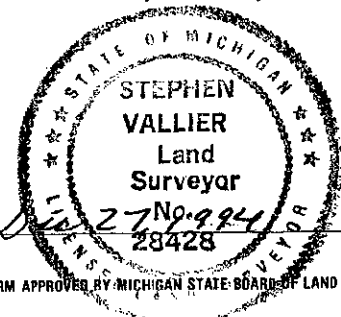

Signed by *Stephen Vallier* Date \_\_\_\_\_

Surveyor's Michigan License No. 28428