

**SURVEY & REMONUMENTATION**

1871 Pg. 648

A1753

APR 04 1996

**COMMISSION**

**LAND CORNER RECORDATION CERTIFICATE**  
Filing Requirement of Act 74, Mich. P.A. 1970

For corners in

<u>Muskegon</u> <small>(County)</small>	Located In:	Corner Code #
1. Public Land Survey	T <u>9N</u> R <u>15W</u>	<u>B-7</u>
	T _____ R _____	_____
	T _____ R _____	_____
2. Property Controlling in Section	S _____ T _____ R _____	_____
	S _____ T _____ R _____	_____
3. Miscellaneous Property in Sec.	S _____ T _____ R _____	_____
	S _____ T _____ R _____	_____

**SURVEY & REMONUMENTATION**

APR 04 1996

Register of Deeds Stamp & File Number

STATE OF MICHIGAN  
 COUNTY OF MUSKEGON  
 REGISTER OF DEEDS  
 886 E. COLEMAN ST. MI 49801  
 RECEIVED  
 APR 10 1996

4. Lot No. \_\_\_\_\_, Recorded Plat \_\_\_\_\_  
 5. Private Claims \_\_\_\_\_

**COMMISSION**

A	B	C	D	E	F	G	H	I	J	K	L	M
2	6	5	4	3	2	1						
3												
4	7	8	9	10	11	12						
5												
6	18	17	16	15	14	13						
7												
8	19	20	21	22	23	24						
9												
10	30	29	28	27	26	25						
11												
12	31	32	33	34	35	36						
13												

I, Stephen V. Vallier, P.S., in a field survey on December 18, 19 95, do hereby certify that under requirements of P.A. 74, Michigan P.A. of 1970, the corner points mentioned in lines 1 and 2 above were in conformance with regulations and rules therefore as required in the current manual of survey instructions of the United States Department of the Interior, Bureau of Land Management or by a decree of a Court of Law and/or that the corner points mentioned in lines 3, 4 and 5 above were in conformance with the rules of the Michigan Board of Land Surveyors or by a Decree of a Court of Law; established, re-established, monumented, re-monumented, recovered, found as expressed below:

**NOTE: Not more than 4 corners, all in the same town and range, may be recorded on this certificate.**

A. Description of original monument and accessories and/or subsequent restoration:

1837 GLO set corner	S 30 deg. E	6 Links	12" Hemlock
	S 80 deg. E	8 Links	18" Hemlock
1950's M.C.R.C. - Iron Pipe	ESE	149.65'	16" Elm
	SSW	61.34'	4" Poplar
	WSW	129.10'	4" Poplar

(see Exhibit "A")

B. Description of corner evidence found and/or method applied in restoring or reestablishing corner:

Found 4" x 30" Cast Iron Monument with County Survey Cap.  
 Checks witnesses L.C.R.C. Liber 1242 Page 305.


POSITION OF SAID RECORDED CORNER REVIEWED & RATIFIED BY MUSKEGON COUNTY PEER GROUP IN ACCORDANCE WITH P.A. 345, OF 1990

Nov 13, 1995

C. Description of monument for corner and accessories established to perpetuate locating the position of the corner:

Found 4" x 30" Cast Iron Monument with County Survey Cap.

N 50 deg W	47.55'	6" Cherry (nail)
S 80 deg W	48.87'	10" Pine (nail)
S 05 deg W	102.05'	12" Stump
N 65 deg E	16.53'	West edge Mi Con Gas marker
S 88 deg E	122.50'	Maple clump (set nail)
S 45 deg W	46.78'	12" White Pine (set nail)
S 28 deg E	60.73'	6" Spruce (set nail)

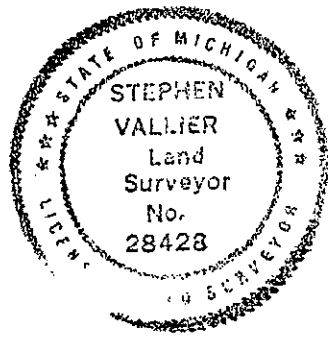

Signed by Stephen V. Vallier Date Dec 15, 1995  
 Surveyor's Michigan License No. 28428