

SURVEY & REMONUMENTATION

R1891 Pg. 650

A1754

APR 04 1996

LAND CORNER RECORDATION CERTIFICATE
Filing Requirement of Act 74, Mich. P.A. 1970

For corners in **COMMISSION**

<u>Muskegon</u> <small>(County)</small>	Located In:	Corner Code #
1. Public Land Survey	T <u>9N</u> R <u>15W</u>	<u>B-8</u>
	T _____ R _____	_____
	T _____ R _____	_____
	T _____ R _____	_____
2. Property Controlling in Section	S _____ T _____ R _____	SURVEY & REMONUMENTATION
	S _____ T _____ R _____	_____
3. Miscellaneous Property in Sec.	S _____ T _____ R _____	_____
	S _____ T _____ R _____	_____

STATE OF MICHIGAN
 COUNTY OF MUSKEGON
 REGISTERED
 1995 OCT 18 PM 4:19

Register of Deeds Stamp & File Number

APR 04 1996

4. Lot No. _____, Recorded Plat _____ **COMMISSION**
 5. Private Claims _____

A	B	C	D	E	F	G	H	I	J	K	L
2	5	5	4	3	2						
3											
4	7	8	9	10	11	12					
5											
6	18	17	16	15	14	13					
7											
8	8	20	21	22	23	24					
9											
10	30	29	28	27	26	25					
11											
12	31	32	33	34	35	36					
13											

I, Stephen V. Vallier, P.S. in a field survey on December 8, 1995, do hereby certify that under requirements of P.A. 74, Michigan P.A. of 1970, the corner points mentioned in lines 1 and 2 above were in conformance with regulations and rules therefore as required in the current manual of survey instructions of the United States Department of the Interior, Bureau of Land Management or by a decree of a Court of Law and/or that the corner points mentioned in lines 3, 4 and 5 above were in conformance with the rules of the Michigan Board of Land Surveyors or by a Decree of a Court of Law; established, re-established, monumented, re-monumented, recovered, found as expressed below:

NOTE: Not more than 4 corners, all in the same town and range, may be recorded on this certificate.

A. Description of original monument and accessories and/or subsequent restoration:

No corner set by GLO.
 1980 C. Shangraw - found 1/2" Iron. Recorded L.C.R.C. Liber 1191 Page 136.
 S 17.50' Centerline of pavement
 S 15 deg. E 47.90' Light Pole (nail E side)
 N 45 deg. E 55.40' 15" Ash (nail NW side)
 1988 D. Sandel survey recorded Liber 1429 Page 827.
 (see Exhibit "A")

B. Description of corner evidence found and/or method applied in restoring or reestablishing corner:

Found 4" x 30" Cast Iron Monument with County Survey Cap in Monument Box. Checks witnesses of Liber 1542 Page 359.


POSITION OF SAID
 RECORDED CORNER
 REVIEWED & RATIFIED
 BY MUSKEGON COUNTY
 PEER GROUP IN ACCORDANCE
 WITH P.A. 345, OF 1990

Aug 1, 1985

C. Description of monument for corner and accessories established to perpetuate locating the position of the corner:

Found 4" x 30" Cast Iron Monument with County Survey Cap in Monument Box.

N 47 deg. E 52.26' 18" Elm (nail)
 N 38 deg. E 118.00' Southwest corner house
 N 16 deg. W 94.45' 6" Pine (nail)
 S 29 deg. W 104.85' 14" Maple (nail)
 S 15 deg. E 47.86' Light Pole (nail)
 S 18± Centerline of pavement

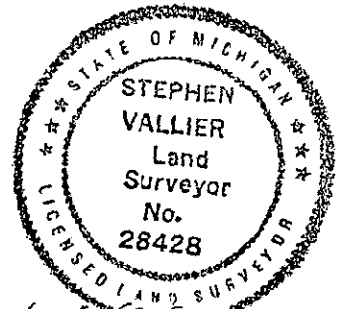

Signed by Stephen V. Vallier Date 12/15/95
 Surveyor's Michigan License No. 28428