

APR 28 1995

LAND CORNER RECORDATION CERTIFICATE
Filing Requirement of Act 74, Mich. P.A. 1970

For corners in
MUSKEGON COMMISSION
(County)

Located In: Corner Code #

- 1. Public Land Survey T 9N R 15W D-2
T _____ R _____
T _____ R _____
T _____ R _____
- 2. Property Controlling S _____ T _____ R _____
in Section S _____ T _____ R _____
- 3. Miscellaneous S _____ T _____ R _____
Property in Sec. S _____ T _____ R _____

A1538

Stephen Vallier
REGISTER OF DEEDS

STATE OF MICHIGAN
COUNTY OF MUSKEGON
RECEIVED FOR RECORD
1994 DEC 27 AM 11:41

Register of Deeds Stamp & File Number

- 4. Lot No. _____, Recorded Plat _____
- 5. Private Claims _____

	A	B	C	D	E	F	G	H	I	J	K	L	M
2	6			4			3			2			
3													
4	7		8		9		10		11		12		
5													
6	18		17		16		15		14		13		
7													
8	19		20		21		22		23		24		
9													
10	30		29		28		27		26		25		
11													
12	31		32		33		34		35		36		
13													

I, STEPHEN V. VALLIER, in a field survey on OCTOBER, 1994, do hereby certify that under requirements of P.A. 74, Michigan P.A. of 1970, the corner points mentioned in lines 1 and 2 above were in conformance with regulations and rules therefore as required in the current manual of survey instructions of the United States Department of the Interior, Bureau of Land Management or by a decree of a Court of Law and/or that the corner points mentioned in lines 3, 4 and 5 above were in conformance with the rules of the Michigan Board of Land Surveyors or by a Decree of a Court of Law; established, re-established, monumented, re-monumented, recovered, found as expressed below.

NOTE: Not more than 4 corners, all in the same town and range, may be recorded on this certificate.

A. Description of original monument and accessories and/or subsequent restoration:

CORNER NOT SET BY GLO

1980 M.C.R.C. TIE MAP
N 70.00' 26" OAK
NW 68.05' 24" TWIN OAK
SW 80.00' 18" OAK
SE 54.90' 24" TWIN OAK

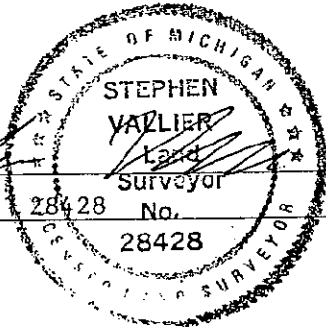
B. Description of corner evidence found and/or method applied in restoring or reestablishing corner:

FOUND 3/4" X 18" IRON PIPE CENTERLINE ROAD
ACCEPTED CORNER AS CORRECT CORNER OF SECTION BY HISTORICAL USAGE AND DOCUMENTATION
N 69.91' 30" OAK
N 45° W 67.22' 28" OAK
S 47° E 53.41' 28" OAK

Sept 6, 1994
POSITION OF SAID
RECORDED CORNER
REVIEWED & RATIFIED
BY MUSKEGON COUNTY
PEER GROUP IN ACCORDANCE
WITH P.A. 345, OF 1900

C. Description of monument for corner and accessories established to perpetuate locating the position of the corner:

SET 4" X 30" CAST IRON MONUMENT WITH COUNTY SURVEY CAP- REPLACED 3/4" IRON PIPE
N 69.91' NAIL W. SIDE 30" OAK
N 43° W 44.37' NAIL E SIDE P. POLE
N 45° W 67.22' NAIL S SIDE 28" OAK
S 59° W 85.00' NAIL N SIDE 26" OAK
S 47° E 53.41' NAIL S SIDE 28" OAK
S 25° W 36.15' NAIL E SIDE TRIPLE OAK

Signed by *Stephen Vallier*
Surveyor's Michigan License No. 28428 No. 28428


Date Dec 27, 1994