

APR 28 1995

LAND CORNER RECORDATION CERTIFICATE
Filing Requirement of Act 74, Mich. P.A. 1970

For corners in **COMMISSION**

<u>MUSKEGON</u> <small>(County)</small>	Located In:	Corner Code #
1. Public Land Survey	T <u>9N</u> R <u>15W</u>	<u>E-1</u>
	T _____ R _____	_____
	T _____ R _____	_____
	T _____ R _____	_____
2. Property Controlling in Section	S _____ T _____ R _____	_____
	S _____ T _____ R _____	_____
3. Miscellaneous Property in Sec.	S _____ T _____ R _____	_____
	S _____ T _____ R _____	_____
4. Lot No. _____, Recorded Plat _____		
5. Private Claims _____		

A1536

STATE OF MICHIGAN
 COUNTY OF MUSKEGON
 RECEIVED FOR RECORD
 1994 DEC 27 AM 11:41
 Register of Deeds Stamp & File Number

I, STEPHEN V. VALLIER, in a field survey on OCTOBER, 1994, do hereby certify that under requirements of P.A. 74, Michigan P.A. of 1970, the corner points mentioned in lines 1 and 2 above were in conformance with regulations and rules therefore as required in the current manual of survey instructions of the United States Department of the Interior, Bureau of Land Management or by a decree of a Court of Law and/or that the corner points mentioned in lines 3, 4 and 5 above were in conformance with the rules of the Michigan Board of Land Surveyors or by a Decree of a Court of Law; established, re-established, monumented, re-monumented, recovered, found as expressed below:

A	B	C	D	E	F	G	H	I	J	K	L	M
2	6	5	4	3	2	1						
3												
4	7	8	9	10	11	12						
5												
6	18	17	16	15	14	13						
7												
8	19	20	21	22	23	24						
9												
10	30	29	28	27	26	25						
11												
12	31	32	33	34	35	36						
13												

NOTE: Not more than 4 corners, all in the same town and range, may be recorded on this certificate.

A. Description of original monument and accessories and/or subsequent restoration:

MAY 1837 GLO SET SECTION CORNER INTERSECTION TOWN LINE 44 LINKS EAST OF POST.
 S 70 DEG. E 10 LINKS 8" BLACK ASH
 S 17 DEG. W 19 LINKS 12" ELM

1950'S M.C.R.C.
 NE 76.85' P. POLE
 SE 126.36' P. POLE
 NW 77.84' 19" ELM WSW 71.82' 25" OAK
 W 29' CORNER 32.33 T 10 N, R 15 W

B. Description of corner evidence found and/or method applied in restoring or reestablishing corner:

FOUND RAILROAD SPIKE OVER 1 1/2" X 18" PIPE.
 ACCEPTED POSITION OF EXISTING CORNER DUE TO CONSISTENT EVIDENCE OF HISTORICAL DOCUMENTATION AND SECTIONAL INFORMATION.

W 29.15' 1 1/2" IRON PIPE

Sept 6 1994 SW


POSITION OF SAID RECORDED CORNER REVIEWED & RATIFIED BY MUSKEGON COUNTY PEER GROUP IN ACCORDANCE WITH P.A. 345, OF 1990

C. Description of monument for corner and accessories established to perpetuate locating the position of the corner:

SET 4" X 30" CAST IRON MONUMENT WITH IRON SURVEY CAP.
 REPLACED RAILROAD SPIKE AND PIPE.

S	77 DEG.	W	36.13'	NAIL N SIDE OAK CLUSTER
S	36 DEG.	E	51.19'	NAIL N SIDE T. POLE
N	83 DEG.	W	29.15'	1 1/2" IRON PIPE
N	6 DEG.	W	162.09'	NAIL E SIDE T. POLE
N	36 DEG.	E	76.81'	NAIL S SIDE P. POLE
S	89 DEG.	E	81.24'	NAIL S SIDE 12" ASPEN

Signed by *Stephen Vallier*
 Surveyor's Michigan License No. 28428

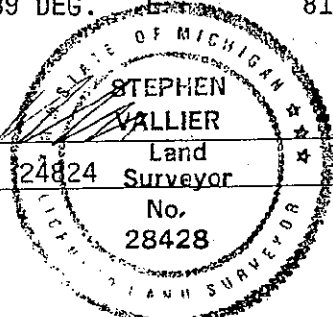

Date Dec 27, 1994