

SURVEY & REMONUMENTATION

(REV) 1810 PAGE 44

APR 28 1995

LAND CORNER RECORDATION CERTIFICATE
Filing Requirement of Act 74, Mich. P.A. 1970

For corners in
MUSKEGON
(County)

COMMISSION

Located In:

Corner Code #

- | | | |
|------------------------------------|-------------------------|-------|
| 1. Public Land Survey | T 9N R 15W | E-8 |
| | T _____ R _____ | _____ |
| | T _____ R _____ | _____ |
| | T _____ R _____ | _____ |
| 2. Property Controlling in Section | S _____ T _____ R _____ | _____ |
| | S _____ T _____ R _____ | _____ |
| 3. Miscellaneous Property in Sec. | S _____ T _____ R _____ | _____ |
| | S _____ T _____ R _____ | _____ |

A1551

STATE OF MICHIGAN
COUNTY OF MUSKEGON
REGISTER OF DEEDS
1994 DEC 27 AM 11:42

Register of Deeds Stamp & File Number

4. Lot No. _____, Recorded Plat _____
5. Private Claims _____

A	B	C	D	E	F	G	H	I	J	K	L	M
2	6	5	4	3	2							
3												
4	7	8	9	10	11	12						
5												
6	16	17	16	15	14	13						
7												
8	19	20	21	22	23	24						
9												
10	30	29	28	27	26	25						
11												
12	31	32	33	34	35	36						
13												

I, **STEPHEN V. VALLIER**, in a field survey on NOVEMBER, 1994, do hereby certify that under requirements of P.A. 74, Michigan P.A. of 1970, the corner points mentioned in lines 1 and 2 above were in conformance with regulations and rules therefore as required in the current manual of survey instructions of the United States Department of the Interior, Bureau of Land Management or by a decree of a Court of Law and/or that the corner points mentioned in lines 3, 4 and 5 above were in conformance with the rules of the Michigan Board of Land Surveyors or by a Decree of a Court of Law; established, re-established, monumented, re-monumented, recovered, found as expressed below:

NOTE: Not more than 4 corners, all in the same town and range, may be recorded on this certificate.


- A. Description of original monument and accessories and/or subsequent restoration:
- | | |
|--|--|
| 1837 GLO SET 1/4 CORNER
N 25° E 4 LINKS 6" HEMLOCK
S 26° W 11 LINKS 6" HEMLOCK | 1980 M.C.R.C., LBR. 1203, PG. 546
FOUND RAILROAD SPIKE-REPLACED WITH 1/2" REROD
IN MON. BOX
WNW 89.81' 10" CHERRY
NW 55.59' 20" MAPLE
NE 81.10' 18" MAPLE
NE 42.98' FENCE POST |
| 1950'S M.C.R.C.
NE 81.42' 6" MAPLE
SE 38.14' STEEL POST
SE 13.68' P. STUMP
NW 55.56' 6" MAPLE
NW 74.45' TWIN POPLAR | |

- B. Description of corner evidence found and/or method applied in restoring or reestablishing corner:
- FOUND 1/2" IRON ROD IN MONUMENT BOX - ACCEPTED POSITION OF EXISTING CORNER DUE TO THE CONSISTENT EVIDENCE OF WITNESS TIES FROM KNOWN DOCUMENTATION
- | | |
|----------------|------------|
| N 30° E 81.10' | 20" MAPLE |
| N 65° W 89.81' | 10" CHERRY |

Aug 2, 1994 SW

POSITION OF SAID
CORNER
WAS RE-ESTABLISHED
BY THE SURVEYOR
ON THE BASIS OF THE
WITNESS TIES OF 1994

- C. Description of monument for corner and accessories established to perpetuate locating the position of the corner:
- SET 4" X 30" CAST IRON MONUMENT WITH COUNTY SURVEY CAP (REPLACED FOUND 1/2" IRON ROD) - PLACED MONUMENT IN MON. BOX
- | | |
|----------------|---------------------|
| N 65° W 89.81' | NAIL IN 10" CHERRY |
| N 30° E 81.10' | NAIL IN 20" MAPLE |
| S 25° E 36.57' | STEEL POST |
| S 48° E 52.36' | GAS PIPELINE MARKER |
| N 50° E 55.65' | FENCE POST |

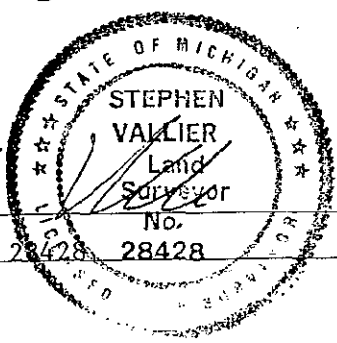

Signed by _____
Surveyor's Michigan License No. 28428

Date Dec 27, 1994