

**SURVEY &  
REMONUMENTATION**

LIBEP **1810** PAGE **45**

**LAND CORNER RECORDATION CERTIFICATE**  
Filing Requirement of Act 74, Mich. P.A. 1970

**APR 28 1995**

For corners in

MUSKEGON **COMMISSION**  
(County)

Located In:

Corner Code ##

- |                                    |   |    |   |     |     |
|------------------------------------|---|----|---|-----|-----|
| 1. Public Land Survey              | T | 9N | R | 15W | E-9 |
|                                    | T |    | R |     |     |
|                                    | T |    | R |     |     |
|                                    | T |    | R |     |     |
| 2. Property Controlling in Section | S | T  | R |     |     |
|                                    | S | T  | R |     |     |
| 3. Miscellaneous Property in Sec.  | S | T  | R |     |     |
|                                    | S | T  | R |     |     |
4. Lot No. \_\_\_\_\_, Recorded Plat \_\_\_\_\_
5. Private Claims \_\_\_\_\_

*A1552*

STATE OF MICHIGAN  
COUNTY OF MUSKEGON  
RECEIVED 1994 DEC 27 AM 11:42  
*Carrie Carter*  
REGISTER OF DEEDS

Register of Deeds Stamp & File Number

I, STEPHEN V. VALLIER, in a field survey on DECEMBER, 19 94, do hereby certify that under requirements of P.A. 74, Michigan P.A. of 1970, the corner points mentioned in lines 1 and 2 above were in conformance with regulations and rules therefore as required in the current manual of survey instructions of the United States Department of the Interior, Bureau of Land Management or by a decree of a Court of Law and/or that the corner points mentioned in lines 3, 4 and 5 above were in conformance with the rules of the Michigan Board of Land Surveyors or by a Decree of a Court of Law; established, re-established, monumented, re-monumented, recovered, found as expressed below:

A	B	C	D	E	F	G	H	I	J	K	L	M
2	6	5	4	3	2	1						
3												
4	7	8	9	10	11	12						
5												
6	18	17	16	15	14	13						
7												
8	19	20	21	22	23	24						
9												
10	30	29	28	27	26	25						
11												
12	31	32	33	34	35	36						
13												

**NOTE: Not more than 4 corners, all in the same town and range, may be recorded on this certificate.**

**A. Description of original monument and accessories and/or subsequent restoration:**

1837 GLO SET SECTION CORNER  
S 56° E 18 LINKS 24" BEECH  
S 51° W 12 LINKS 6" HEMLOCK

1981 C.F. LEWANDOWSKI SET 1/2" IRON ROD BY OLD M.C.R.C. WITNESS TIES


1950'S M.C.R.C.  
SSE 29.81' 8" MAPLE  
NW 28.75' TWIN MAPLE  
W 3.0' 8" ELM

**B. Description of corner evidence found and/or method applied in restoring or reestablishing corner:**  
FOUND 1/2" IRON ROD 3' WEST OF N-S FENCLINE AND 23' NORTH OF N-S/E-W FENCE INTERSECTION  
N 63° W 24.85' 12" MAPLE  
ACCEPTED POSITION OF EXISTING CORNER DUE TO EXISTING DOCUMENTATION AND HISTORICAL USAGE

*Aug 2, 1994*  
POSITION OF SAID RECORDED CORNER REVIEWED & RATIFIED BY MUSKEGON COUNTY PEER GROUP IN ACCORDANCE WITH P.A. 345, OF 1990

**C. Description of monument for corner and accessories established to perpetuate locating the position of the corner:**  
SET 2 3/4" X 30" CAST IRON MONUMENT WITH COUNTY SURVEY CAP

N 63° W	24.85'	NAIL S. SIDE	12" MAPLE
S 75° W	20.00'	NAIL S. SIDE	16" ELM
S 45° E	11.02'	NAIL S. SIDE	16" ELM
S 0° E	14.43'	NAIL E. SIDE	16" ASH
S 33° W	23.31'	NAIL W. SIDE	16" MAPLE
N 88° W	33.88'	NAIL N. SIDE	16" ELM

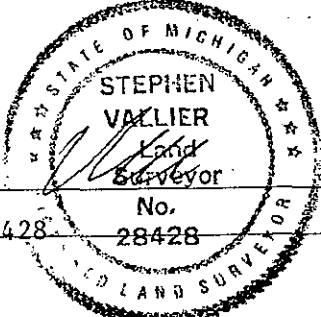

Signed by *Stephen Vallier* Date *Dec 27, 1994*  
Surveyor's Michigan License No. 28428 28428