~~SURVEY &~~
REMONUMENTATION

APR 28 1995

COMMISSION

LIBER 1810 PAGE 46

ok

LAND CORNER RECORDATION CERTIFICATE

Filing Requirement of Act 74, Mich. P.A. 1970

STATE OF MICHIGAN
COUNTY OF MUSKEGON
RECEIVED FOR RECORD
1994 DEC 27 AM 11:42
Carolyn Conti
REGISTER OF DEEDS

A1553

Register of Deeds Stamp & File Number

For corners in

MUSKEGON (County)

	Located In:	Corner Code #
1. Public Land Survey	T 9N R 15W	E-10
	T ___ R ___	
	T ___ R ___	
	T ___ R ___	
2. Property Controlling	S ___ T ___ R ___	
in Section	S ___ T ___ R ___	
3. Miscellaneous	S ___ T ___ R ___	
Property in Sec.	S ___ T ___ R ___	

4. Lot No. _____, Recorded Plat _____
5. Private Claims _____

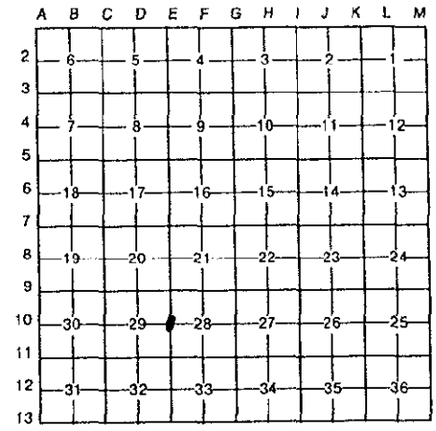

I, STEPHEN V. VALLIER, in a field survey on DECEMBER, 19 94, do hereby certify that under requirements of P.A. 74, Michigan P.A. of 1970, the corner points mentioned in lines 1 and 2 above were in conformance with regulations and rules therefore as required in the current manual of survey instructions of the United States Department of the Interior, Bureau of Land Management or by a decree of a Court of Law and/or that the corner points mentioned in lines 3, 4 and 5 above were in conformance with the rules of the Michigan Board of Land Surveyors or by a Decree of a Court of Law; established, re-established, monumented, re-monumented, recovered, found as expressed below:

NOTE: Not more than 4 corners, all in the same town and range, may be recorded on this certificate.

A. Description of original monument and accessories and/or subsequent restoration:

1837 GLO SET 1/4 SECTION POST
N 77° E 6 LINKS 15" BEECH
N 63° W 11 LINKS 18" SUGAR

1972 D. FREER, LBR. 979, PG. 344
FOUND IRON
SE 62.40' 24" BEECH
N 34.25' 10" CHERRY
SW 58.36' 14" APPLE

B. Description of corner evidence found and/or method applied in restoring or reestablishing corner:

FOUND ½" X 18" IRON - ACCEPTED POSITION OF CORNER DUE TO CONSISTENT EVIDENCE OF SECTIONAL MEASURES AND KNOWN DOCUMENTATION, Found Iron Bar 2' South and 8' East.

N 15° W 38.14' 12"-14" TWIN CHERRY

Aug 2, 1994 SL

POSITION OF SAID
RECORDED CORNER
REVIEWED & RATIFIED
BY MUSKEGON COUNTY
PEER GROUP IN ACCORDANCE
WITH P.A. 345, OF 1990

C. Description of monument for corner and accessories established to perpetuate locating the position of the corner:

SET 2 3/4" X 30" CAST IRON MONUMENT WITH COUNTY SURVEY CAP-REPLACED ½" X 18" IRON

S 27° W 37.11' NAIL IN N. SIDE 12" BEECH
S 5° W 32.17' NAIL W. SIDE 10" BEECH
S 14° E 35.01' NAIL W. SIDE 4" BEECH
N 74° E 91.28' NAIL S. SIDE 52" ASH
N 15° W 38.13' NAIL E. SIDE 12-14" TWIN CHERRY

STATE OF MICHIGAN
STEPHEN VALLIER
Land Surveyor
No. 28428
SURVEYOR

Signed by _____ Date Dec 27 1994

Surveyor's Michigan License No. 28428

FORM APPROVED BY MICHIGAN STATE BOARD OF LAND SURVEYORS, JAN. 28, 19
REVISED MAY 14, 19
REVISED JAN., 19